
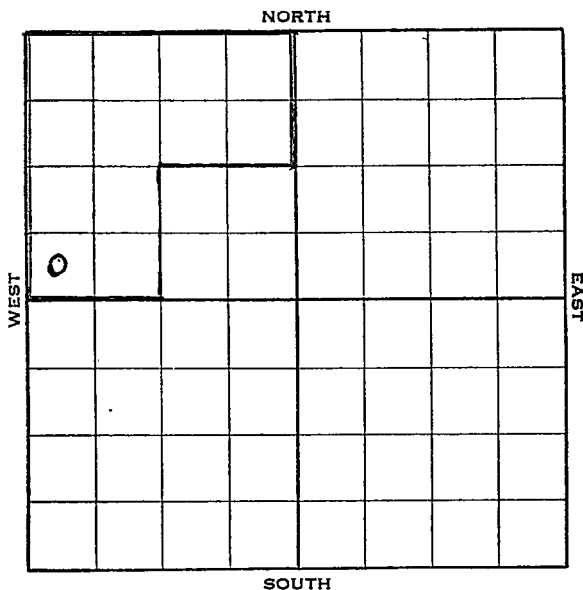


Section 16 Township 16 Range 10WWell No. 1 BoyeCompany I.T.I.O.

Sec. 16 Twp. 16 R. 10-WWell No. #1 Boye FarmI. T. I. O. Company Ft. from N. Line330 Ft. from S. Line Ft. from E. Line330 Ft. from W. Line

Elev. 1885

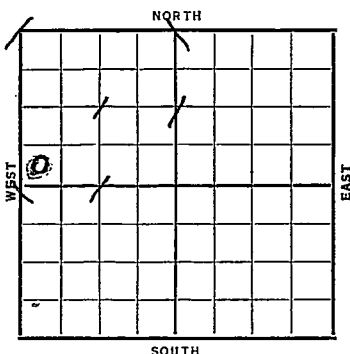

Date	REPORT
1938	
3/2	Location
3/11	"
3/18	"
3/25	"
4/1	"
4/8	"
4/15	"
4/22	"
4/29	"
5/6	"
5/12	"
5/20	"
5/27	"
6/3	B.R.R.
6/10	R U R
6/17	10" - 561' Anhy. 667' Drlg. 1375'
6/24	Drlg. 2918'
7/1	Lans. 3025' - Arb. 3343- & 7"
	T.D. 3345' S.O. RUST
	OVER

1938

7/8 T. D. 3353'. 2500' oil in 45
Min. 3200' oil 2 hrs.

7/13 7" - 3343'.
Arb. 3343'.
T. D. 3353'.
Pump 304 bbls. 4 hrs. & 330 bbls.
4 hrs.
Potential 1824 bbls., Nat'l.

COMPLETED

Ellsworth KANSAS

Map No. 55 Sec. 16 Twp. 16 R. 10WWell No. 1 Boye

I T I O

Company

Contractor

FIRST REPORT

SW NW


Ft. from N. Line

330 Ft. from S. Line

Ft. from E. Line

330 Ft. from W. Line

SECTION PLAT

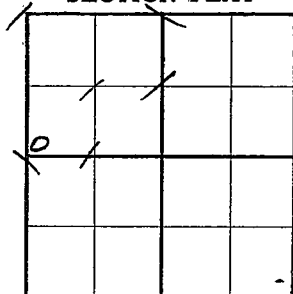Location X

RECORD

Cased _____ in., _____ ft.

Sand _____

Gas _____

Oil _____

Total Depth _____

PRODUCTION

1st 24 hrs. Nat. _____

1st 24 hrs. after shot _____

Gas _____ Cu. Ft.

Dry Hole _____

Abandoned _____

Date

MAR 2 - 1938

19

H. D. Hatfield

Scout

Ellsworth KANSAS

Map No. 55 Sec. 16 Twp. 16 R. 10WWell No. 1 BoyeI T I O

Company

Contractor

COMPLETED

SW NW

SECTION PLAT

0			

 Ft. from N. Line330 Ft. from S. Line Ft. from E. Line330 Ft. from W. LineLocation Rig up

Drilling and Remarks:

Pump 304/4 + 330/4
PT 1824
NAT

RECORDCased 7 in., 3343 ft.Sand Arb 3343Gas Oil Total Depth 3353**PRODUCTION**1st 24 hrs. Nat. 1st 24 hrs. after shot Gas Cu. Ft.Dry Hole Abandoned

Date

JUL 13 1938

19

H. D. Hatfield Scout