

KANSAS

Form 51-5M-7-39-Palace


Ellsworth

Section 16 Township 16 Range 10-W

Well No. #1 Boye

Company I.T.I.O.

NORTH Stoltenberg Pool

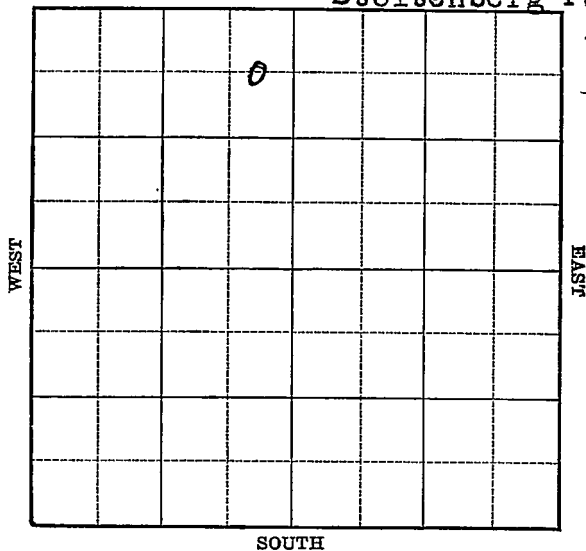

KANSAS

Ellsworth

Sec. 16 Twp. 16 R. 10-WWell No. #1 Boye Farm


I T I O

Company

(Stoltenberg)

660 Ft. from N. Line Ft. from S. Line330 Ft. from E. Line Ft. from W. Line

Elev. 1841

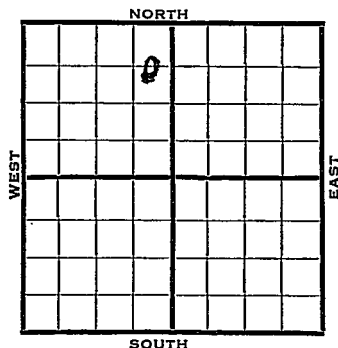

1940	REPORT
5/22	Location
5/29	"
6/6	10" - 542' Drlg. 2700'
6/13	Arb. ³³³⁷ 3340 42' T.D. S.O.
	7" - ³³³⁸ 3340 RUST.
6/20	Arb. 3337' (Corrected)
	7" - 3338' T.D. 3344'
	Swab 10 bbls. per hour, 10% wtr.
6/26	Arb. 3337'
	7" - 3338'
	T.D. 3344'
	Pump 19 oil & 19 water.
	15 bbls.
	COMPLETED

Map No. 55 Sec. 16 Twp. 16 R. 10WWell No. 1 Boye


I T I O

Company

Contractor

FIRST REPORT

SECTION PLAT

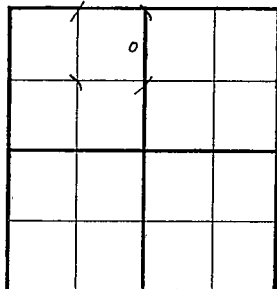C E L NE NW
660 Ft. from N. Line Ft. from S. Line330 Ft. from E. Line Ft. from W. Line

STOLTENBERG POOL

Location XRig up

Drilling and Remarks:

RECORD

Cased in., ft.Sand Gas Oil Total Depth

PRODUCTION

1st 24 hrs. Nat. 1st 24 hrs. after shot Gas Cu. Ft.Dry Hole Abandoned

Date

MAY 22 1940₁₉

S. J. LEWIS Scout

Map No. 55 Sec. 16 Twp. 16 R. 10WWell No. 1 BoyeI T I O

Company

Contractor

COMPLETED**C E L N E N W****SECTION PLAT**

660 Ft. from N. Line Ft. from S. Line330 Ft. from E. Line Ft. from W. Line

Stoltenberg Pool

Location Rig up

Drilling and Remarks:

*ac & 3338**7" @ 3338.**Pump 19 oil 19W.**15886***RECORD**Cased in., ft.Sand Gas Oil Total Depth 3344**PRODUCTION**1st 24 hrs. Nat. 1st 24 hrs. after shot Gas Cu. Ft.Dry Hole Abandoned

Date

JUN 26 1940 19S. J. LEWIS Scout