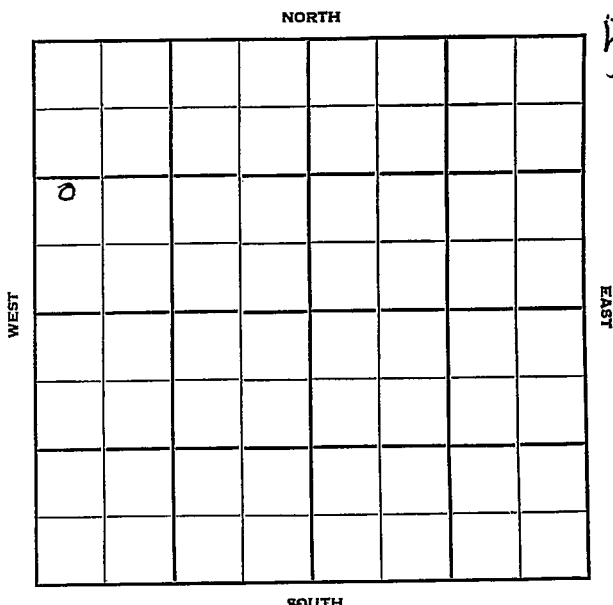


Section 16 Township 16 Range 10WWell No. #4 M. Baye(Boye)Company Cities Service Oil

Ellsworth

Sec. 16 Twp. 16 R. 10W ☒

Well No. #4 M. Boye Farm

Cities Service Oil Company

Contractor

Stoltenberg


 Ft. from N. Line

1290 Ft. from S. Line

 Ft. from E. Line

330 Ft. from W. Line

NW SW NW

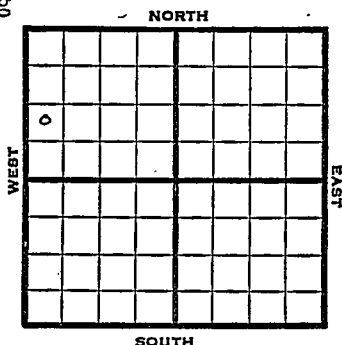

1951	Elev. 1858'	REPORT
11/14	Spud 11-11-51 Drlg. 515'	
12/5	Spud 11-11-51 Oil Well T ^u 3326 8" @ 562 Lans. 2996 Simp. 3308 Arb. 3321-26 5" @ 3322 CO to 3326 FU 1300' oil 9000 wtr. 20 hr. P/ 39 BO 63BW 11 hr. Comp. 45 BOPD 169 BW	
	COMPLETED	

County Ellsworth State KansasSec. 16 (Blk.) 16 (Sur.) 10W Map No.Operator Cities Service OilWell No. 4 Farm M, BayeElev. Location NW SW NW

1290 Ft. From S Line NW330 Ft. From W Line Quarter1st. Report NOV 14 1951

Completion

Remarks

Spudding Date 11-11-51Drig. Data StoltenbergDrig. 515

J. E. TYRA

County Ellsworth State KansasSec. 16 (Blk. Twp.) 16 (Sur. Rge.) 10W Map No. _____Operator Cities Service OilWell No. 4 Farm M. BoyeElev. 1858 Location NW SW NW

o							

1290 Ft. From S Line NW330 Ft. From W Line Quarter

1st. Report _____

Completion DEC 5 1951Remarks Stoltenberg PoolSpudding Date 11-11-51Drlg. Data Oil well TD 33268" @ 562 Lans. 2996 Simp. 3308Arb. 3321-26 5" @ 3322 CO to 3326FU 1300' oil 900' water 20 hr.P/ 39 bo 63 bw 11 hr.Comp. 45 bopd 169 bw

J. E. TYRA