

KANSAS


Ellsworth

Form 51-5M-7-40-Palace

Section 16 Township 16 Range 10-W

Well No. #2 Hagy

Company Phillips et al

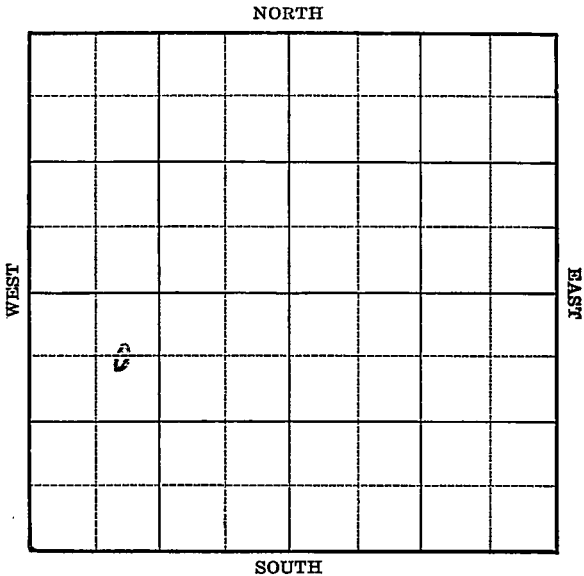

Sec. 16 Twp. 16 R. 10-W

Well No. #2 Hagy Farm                     

Phillips et al \_\_\_\_\_ Company

(Stoltenberg)


660 Ft. from N. Line

\_\_\_\_\_ Ft. from S. Line

\_\_\_\_\_Ft. from E. Line

990 Ft. from W. Line

Elev. 1909

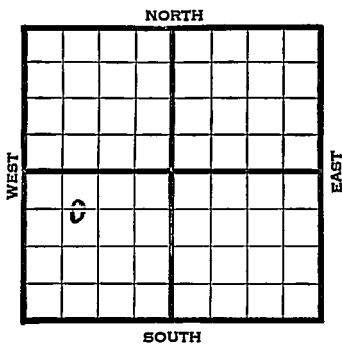[illegible]

Map No. 55 Sec. 16 Twp. 16 R. 10WWell No. 2 HagyPhillips etal

Company

Contractor

**FIRST REPORT****C E L NW SW**660 Ft. from N. Line       Ft. from S. Line       Ft. from E. Line990 Ft. from W. Line**STOLTENBERG POOL****SECTION PLAT**

|  |  |  |  |
|--|--|--|--|
|  |  |  |  |
|  |  |  |  |
|  |  |  |  |
|  |  |  |  |

Location                     Rig up                     

Drilling and Remarks:

**Derrick****RECORD**Cased            in.,            ft.Sand                     Gas                     Oil                     Total Depth                     **PRODUCTION**1st 24 hrs. Nat.                     1st 24 hrs. after shot                     Gas                      Cu. Ft.Dry Hôle                     Abandoned                     

Date

SEP 11 194019S. J. LEWIS Scout

Map No. 55 Sec. 16 Twp. 16 R. 10WWell No. 2 HagyPhillips Petroleum Company

Contractor

**COMPLETED**

C E L NW SW

**SECTION PLAT**

|   |  |  |  |
|---|--|--|--|
|   |  |  |  |
|   |  |  |  |
| 0 |  |  |  |
|   |  |  |  |

660 Ft. from N. Line       Ft. from S. Line       Ft. from E. Line990 Ft. from W. Line**STOLTENBERG POOL**Location                                 Rig up                                 

Drilling and Remarks:

*CU 3376**5" @ 3376**Echord 3384**Max 3000***RECORD**Cased            in.,            ft.Sand                                 Gas                                 Oil                                 Total Depth 3384**PRODUCTION**1st 24 hrs. Nat.                                 1st 24 hrs. after shot                                 Gas                                  Cu. Ft.Dry Hole                                 Abandoned                                 

Date

OCT 16 1940 19S. J. LEWIS Scout