

O. W. P. B

Ellsworth


FORM 51 5M 4-41 PETROL

KANSAS

Section 16 Township 16 Range 10-W


Well No. #2 Hagy

Company Cities Service Oil
(Stoltenberg)

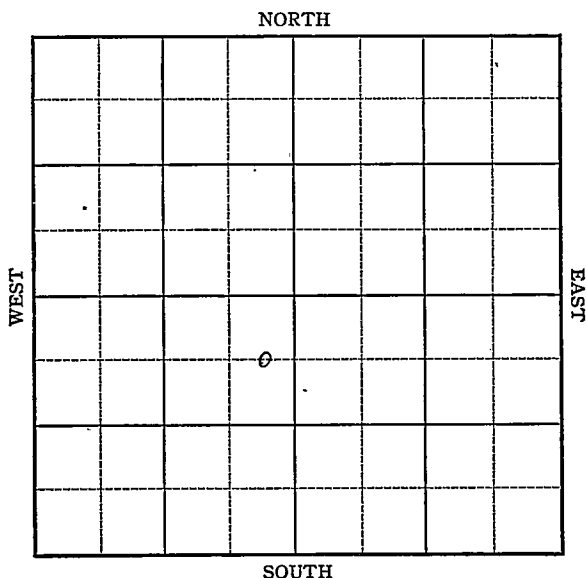

Sec. 16 Twp. 16 R. 10-WWell No. #2 Hagy FarmCities Service oil Company
(Stoltenberg)660 Ft. from N. Line Ft. from S. Line330 Ft. from E. Line Ft. from W. Line

Elev. 1880

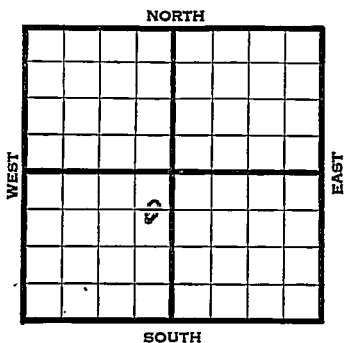

1941

REPORT

7/23

Location

7/31

Rotary

8/7

8" @ 400 Drlg. 1269'

8/15

Drlg. 3189'

8/21

Lans. 3027' Arb. 3350'

5" - 3356' T.D. 3364'

1800' oil 18 hours.

8/27

Arb. 3350'

5" - 3356'

T.D. 3364'

2500 acid.

Potential 529 bbls., pump.

44. Gravity

COMPLETED

Map No. _____ Sec. 16 Twp. 16 R. 10WWell No. 2 Hagy

_____ Cities Service Oil _____ Company

_____ **FIRST REPORT** _____ Contractor

SECTION PLAT

C EL NE SW

660 Ft. from N. Line

_____ Ft. from S. Line

330 Ft. from E. Line

_____ Ft. from W. Line

STOLTENBERG POOL

Location X

Rig up _____

Drilling and Remarks:

RECORD

Cased _____ in., _____ ft.

Sand _____

Gas _____

Oil _____

Total Depth _____

PRODUCTION

1st 24 hrs. Nat. _____

1st 24 hrs. after shot _____

Gas _____ Cu. Ft.

Dry Hole _____

Abandoned _____

Date

JUL 23 1941

19

S. J. LEWIS

Scout

Map No. _____ Sec. 16 Twp. 16 R. 10W

Well No. 2 Hagy

Cities Service Oil Company

COMPLETED Contractor

SECTION PLAT

	0		

C E L NE SW

660 Ft. from N. Line

_____ Ft. from S. Line

330 Ft. from E. Line

_____ Ft. from W. Line

STOLTENBERG POOL

Location _____

Rig up _____

Drilling and Remarks:

*Cr 73350**5' @ 8356**2500 acid**Pump 529 Bx**44 e g*

RECORD

Cased _____ in., _____ ft.

Sand _____

Gas _____

Oil _____

Total Depth *3364*

PRODUCTION

1st 24 hrs. Nat. _____

1st 24 hrs. after shot _____

Gas _____ Cu. Ft.

Dry Hole _____

Abandoned _____

Date

AUG 27 1941 19 S. J LEWIS Scout

O. W. P. B

FORM 513 SUNRAY

County Ellsworth Elev. 1880
 Sec. 16 Twp. 16 Rge. 10W
 Company C. S. O.
 FarmName Hagy No. 2

TOPS	DEPTH	LOG	DATUM
Anh.			
Tr.			
H.			
Tr.			
Dg.			
BL.			
L.		3027	
K.C.			
B.K.C.			
Ce.			
C.			
M.			
M.			
K.			
Mz.			
Me.			
V.			
S.		3342	
S.		3350	
A.			
R.			
PE.			
G.			
T.D.		3364	

Loc. in Sec. E/2 NE SW
(OWPB)

Geol. _____
 Contr. _____

Pool _____

ABANDONED
 FIRST REPORT

Date Comm. Old info. 5" @ 3356. Arb well, New Info.
PB 3296, 54/3203-17, 1000A, Pu 6 BO/ 12 BW
/3, Oil Exh., D & A

12