


Ellsworth

Section 16 Township 16 Range 10-W

Well No. 1 - Hoky

Company Colonial Oil

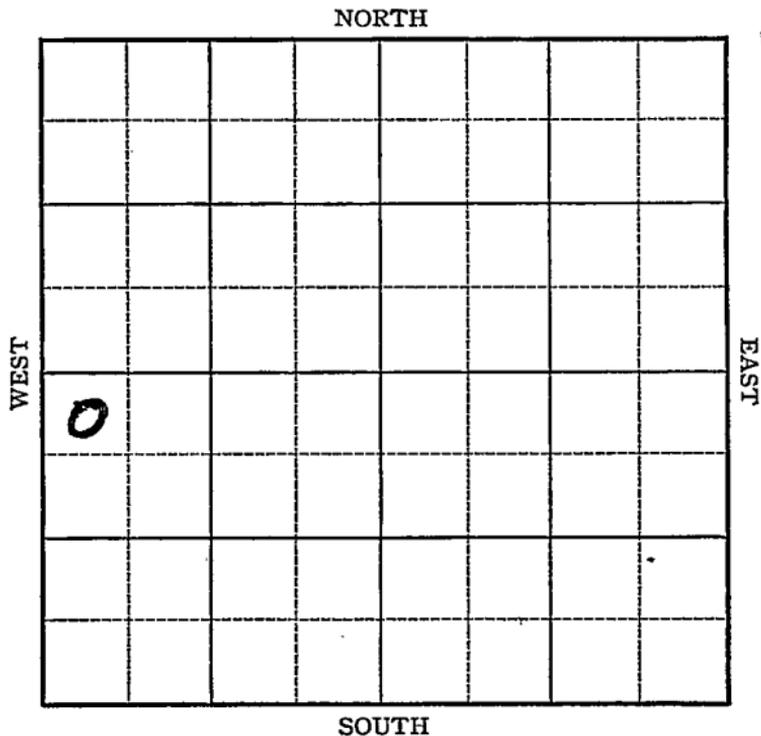

Sec. 16 Twp. 16 R. 10-W

Well No. #1 Hoky Farm


Colonial Oil Company

330 Ft. from N. Line

 Ft. from S. Line

 Ft. from E. Line

330 Ft. from W. Line

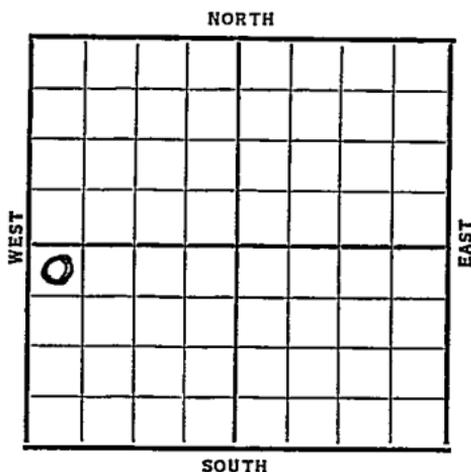

Date	REPORT
1937	
8/4	Location
8/13	"
8/20	"
8/28	Mat.
9/3	"
9/10	"
9/17	R. U.
9/24	"
10/2	"
10/8	"
10/15	"
10/22	"
10/29	"
11/5	"
11/12	"
11/19	"
11/26	"
12/3	"
12/10	15" @ 328'. Drlg. 425'.

OVER



1937

12/17 ~~ANY~~ Anhy 640'. 12" @ 678'.
Drlg. 690'.

12/24 Drlg. 1685'.

12/31 Fort Riley 1630'. 10" @ 1860'.
C.O.

1938

1/7 Drlg. 2115'.

1/14 U. R. 10" @ 2155'.

1/20 10" - 2111' T.D. 2365'
Cleaning out.

1/28 Topeka 2595' 8" - 2675'
Drlg. 2680'.

2/4 Topeka 2635' (Corrected)
S.O. 2850' Lans. 3033' S.O. 3045-50'
Drlg. 3120'

2/11 Arb. 3329'. 7" @ 3331'.
T.D. 3342'. H.F.O. 23 hrs.

2/18 " " " " "

2/26 " " " " "

3/4 T.D. 3342' equals 3358'.
Arb. 3344'g Pump 25 oil in
30 min. & 47 oil next 2 hrs &
28 oil next hr & pumped off.

3/11 Pumped 25 oil per hour for
5 hours. 500 acid.
Pump 302 oil in 5 hrs.

OVER

44-2

1938

3/16

7" @ 3331'.

Arb. 3344'.

T.D. 3358'.

500 acid.

Potential 1219 bbls.

Gravity 44.4

COMPLETED

Ellsworth

Map No. 55 Sec. 16 Twp. 16 R. 10 W

Well No. 1-Hazy

Colonial Oil Company

Contractor

FIRST REPORT

SECTION PLAT

330 Ft. from N. Line
 _____ Ft. from S. Line
 _____ Ft. from E. Line
330 Ft. from W. Line

0			

Location

Rig up _____

Drilling and Remarks:

RECORD

Cased _____ in., _____ ft.

Sand _____

Gas _____

Oil _____

Total Depth _____

PRODUCTION

1st 24 hrs. Nat. _____

1st 24 hrs. after shot _____

Gas _____ Cu. Ft.

Dry Hole _____

Abandoned _____

Date

AUG 4 - 1937
 19

H. D. Hatfield Scout

Ellsworth **KANSAS**Map No. 55 Sec. 16 Twp. 16 R. 10WWell No. 1 HagyColonial Oil

Company

Contractor

COMPLETED

NW SW

SECTION PLAT330 Ft. from N. Line

_____ Ft. from S. Line

_____ Ft. from E. Line

330 Ft. from W. Line

0			

Location _____

Rig up _____

Drilling and Remarks:

*500 Acid**POT 1219**graw 44.4***RECORD**Cased 7 in., 333 ft.Sand Arb 3.344

Gas _____

Oil _____

Total Depth 3358**PRODUCTION**

1st 24 hrs. Nat. _____

1st 24 hrs. after shot _____

Gas _____ Cu. Ft.

Dry Hole _____

Abandoned _____

Date

MAR 16 1938

19

H. D. Hatfield Scout