

11

32


7E

Section _____ Township _____ Range _____

Well No. #8 Miller

Company B.M.B. Management

NORTH

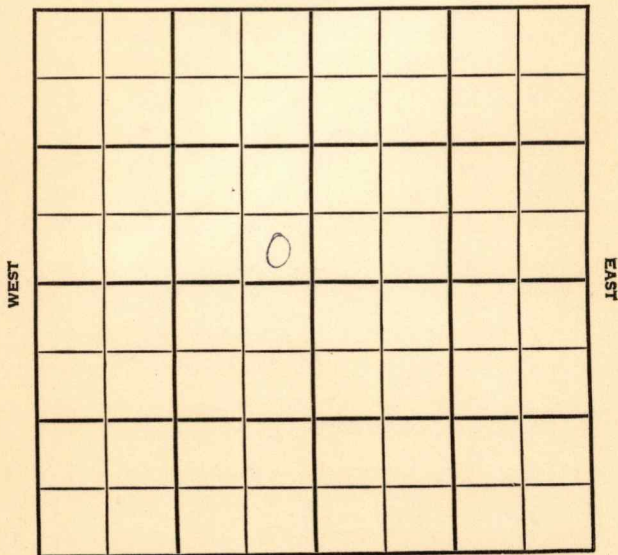

SOUTH

County Cowley Elev. _____
 Sec. 11 Twp. 32 Rge. 7E
 Company B. M. B. Management
 Farm Name Miller No. 8

TOPS	DEPTH	LOG	DATUM
Anh.			
Tp.			
H.			
Tr.			
Dg.			
Bl.			
L.			
K.C.			
B.K.C.			
Ce.			
C.			
M.			
M.			
K.			
Mz.			
Mo.			
V.			
S.			
S.			
A.			
R.			
PE.			
G.			
T.D.			

Loc. in Sec. _____
SE SE NW
 Geol. _____
 Contr. _____
Kirkpatrick
Pools
School Creek No. _____



Date Comm. _____

Location _____

(Red stamp: OCT 15 1960)
(Red stamp: OCT 15 1960)
(Large red scribble)
(Red stamp: R.G.)

Co.
Lse.
Mo.
Sec.
T.
R.

County Cowley Elev. 1399
 Sec. 11 Twp. 32 Rge. 7E
 Company B. M. B. Management
 Farm Name Miller No. 8

TOPS	DEPTH	LOG	DATUM	Loc. in Sec.						
Anh.				SE SE NW						
TP.										
H. <u>Stall</u>		<u>1646</u>								
Tr.										
Dg.										
Bl.										
L.		<u>1850</u>		Geol.						
K.C. <u>Lay</u>		<u>2114</u>		Contr.						
B.K.C.				<u>Kirkpatrick</u>						
Ce.				<u>Tools</u>						
C.				<u>School Creek</u> No.						
M.				<table border="1"> <tr> <td colspan="2">COMPLETE</td> </tr> <tr> <td colspan="2">o</td> </tr> <tr> <td>DEC</td> <td>5 '56</td> </tr> </table>	COMPLETE		o		DEC	5 '56
COMPLETE										
o										
DEC	5 '56									
M.										
K.										
Mz.										
Mo.										
V.										
S.										
S.										
A.										
R.										
PE.										
G.										
TD.	<u>2190</u>									

Date Comm. NOV 24 '56 OCT 31 '56 MIRT NOV 7 '56

10-29-56 8 5/8 28/100
5 1/2 @ 2188/100 NOV 13 '56 CO 2158
60/2142-52 FRAC 3x3 POP
NOV 21 '56 ✓ NOV 28 '56 ✓ DEC 5 '56 P. 30
Bopd + wtr