

# KANSAS

Form 51-5M-7-40-Palace


Ellsworth

Section 16 Township 16 Range 10-W

Well No. #2 Boye

Company I. T. I. O.

NORTH Stoltenberg Pool

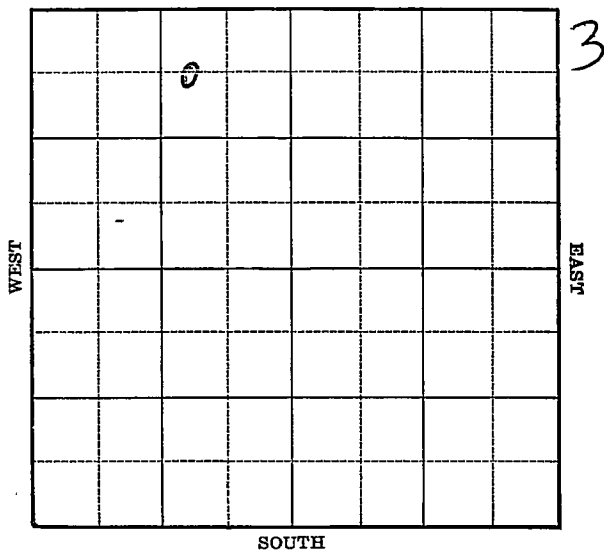

Sec. 16 Twp. 16 R. 10-WWell No. #2 Boye FarmI.T.I.O.

Company

(Stoltenberg)

660

Ft. from N. Line


Ft. from S. Line

990

Ft. from E. Line

Ft. from W. Line

Elev. 1824

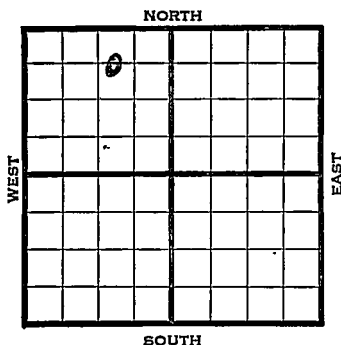

| 1940  | REPORT                                  |
|-------|-----------------------------------------|
| 10/2  | 10" - 445'                              |
|       | Drlg. 1045'                             |
| 10/10 | Drlg. 2805'                             |
|       | 3329'                                   |
| 10/17 | Arb. <del>5303-03</del> T.D. 7" - 3303' |
|       | RUST.                                   |
| 10/24 | Sand 3303 to 3305'                      |
|       | Arb. 3329' (Corrected)                  |
|       | Simp. sand 3302' T.D. 3343'             |
|       | 125' water. P.B. to Simp. sand.         |
| 10/30 | Arb. 3329'                              |
|       | 7" - 3303'                              |
|       | T.D. 3343'                              |
|       | P.B. to 3306'                           |
|       | 24 shots 3298-3306'                     |
|       | 500 acid.                               |
|       | Water.                                  |
|       | ABANDONED                               |

Map No. 55 Sec. 16 Twp. 16 R. 10WWell No. 2 BoyeI T I O

Company

Contractor

**FIRST REPORT**

C W L NE NW

660 Ft. from N. Line       Ft. from S. Line990 Ft. from E. Line       Ft. from W. Line**STOLTENBERG POOL****SECTION PLAT**

|  |   |  |  |
|--|---|--|--|
|  | 0 |  |  |
|  |   |  |  |
|  |   |  |  |
|  |   |  |  |

Location                                 Rig up                                 

Drilling and Remarks:

10" - 445Drlg. 1045**RECORD**Cased            in.,            ft.Sand                                 Gas                                 Oil                                 Total Depth                                 **PRODUCTION**1st 24 hrs. Nat.                                 1st 24 hrs. after shot                                 Gas                                  Cu. Ft.Dry Hole                                 Abandoned                                 

Date

OCT 2 1940<sub>19</sub>S. J. LEWIS Scout

Map No. 55 Sec. 16 Twp. 16 R. 10WWell No. 2 BoyeI T I O\_\_\_\_\_  
Company\_\_\_\_\_  
Contractor**ABANDONED****C W L NE NW**660 Ft. from N. Line55 Ft. from S. Line990 Ft. from E. Line       Ft. from W. Line**STOLTENBERG POOL****SECTION PLAT**

|  |   |  |  |
|--|---|--|--|
|  | 0 |  |  |
|  |   |  |  |
|  |   |  |  |
|  |   |  |  |

Location \_\_\_\_\_

Rig up \_\_\_\_\_

Drilling and Remarks:

*Pl 43329**7" 3303**PB3306**24 Sh. to 3258-3306**500 acid**Water***RECORD**

Cased \_\_\_\_\_ in., \_\_\_\_\_ ft.

Sand \_\_\_\_\_

Gas \_\_\_\_\_

Oil \_\_\_\_\_

Total Depth *3343***PRODUCTION**

1st 24 hrs. Nat. \_\_\_\_\_

1st 24 hrs. after shot \_\_\_\_\_

Gas \_\_\_\_\_ Cu. Ft.

Dry Hole \_\_\_\_\_

Abandoned \_\_\_\_\_

Date

OCT 30 1940 19S. J. LEWIS Scout