

KANSAS

Form 51—5M—7-39—Palace

Ellsworth

Section 16 Township 16 Range 10-W

Well No. #2 Boye

Company I.T.I.O.

NORTH Stoltenberg Pool

WEST	0							EAST

SOUTH

4

KANSAS

Ellsworth

Sec. 16 Twp. 16 R. 10-WWell No. #2 Boye Farm

I T I O

Company

(Stoltenberg)


660 Ft. from N. Line

Ft. from S. Line

Ft. from E. Line

330 Ft. from W. Line

Elev. 1888

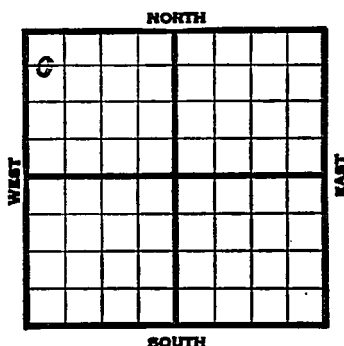

REPORT

1940	
1/17	Location
1/25	"
2/1	Rotary.
2/8	"
2/15	10" - 503' WOC.
2/23	Drlg. 1200'
2/29	Anhy 677' Topeka 2730'
	Drlg. 2740'
3/8	Arb. 3366-69' T.D. S.O.
	7" - 3367' RUST.
3/13	Arb. 3366'
	7" - 3367'
	T.D. 3372'
	750 acid.
	Depthograph potential 7650 bbls.
	Maximum 3000 bbls.
	COMPLETED

Map No. 53 Sec. 16 Twp. 16 R. 10WWell No. 2 Boye

I T I O

Company

Contractor

FIRST REPORT

C W L NW NW

660 Ft. from N. Line Ft. from S. Line Ft. from E. Line330 Ft. from W. Line

STOLTENBERG POOL

SECTION PLAT

0			

Location XRig up

Drilling and Remarks:

RECORD

Cased in., ft.Sand Gas Oil Total Depth

N PRODUCTION

1st 24 hrs. Nat. 1st 24 hrs. after shot Gas Cu. Ft.Dry Hole Abandoned

Date

JAN 17 1940

19

S. J. LEWIS

Scout

Map No. 55 Sec. 16 Twp. 16 R. 10WWell No. 2 BoyeI T I O

Company

Contractor

COMPLETED**C W L NW NW****SECTION PLAT**

0			

660 Ft. from N. Line Ft. from S. Line Ft. from E. Line330 Ft. from W. Line**STOLTENBERG POOL**Location Rig up

Drilling and Remarks:

*Ac 8 3366**7" @ 3367**750 acid**Dep. thog seph 2 &**7650**Maximum 3000***RECORD**Cased in., ft.Sand Gas Oil Total Depth 3372**PRODUCTION**1st 24 hrs. Nat. 1st 24 hrs. after shot Gas Cu. Ft.Dry Hole Abandoned

Date

MAR 13 1940S. J. LEWIS Scout