

KANSAS

Form 51-5M-7-40-Palace


Ellsworth

Section 16 Township 16 Range 10-W

Well No. #3 Boye

Company I.T.I.O.

NORTH Stoltenberg Pool

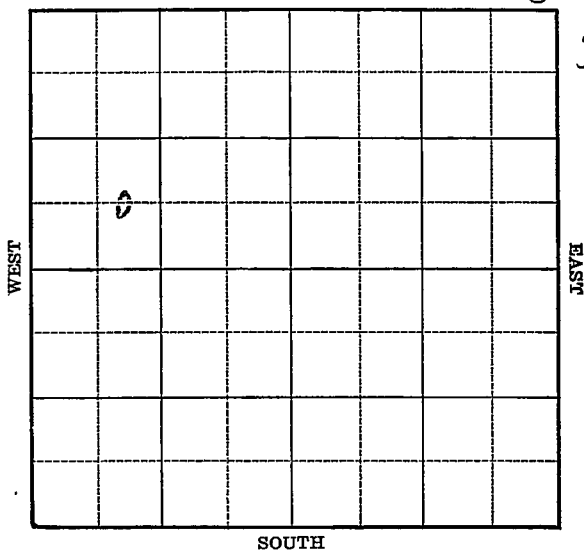

Sec. 16 Twp. 16 R. 10-W

Well No. #3 Boye Farm

I.T.I.O. _____ Company

(Stoltenberg)


_____ Ft. from N. Line

660 Ft. from S. Line

Ft. from E. Line

990 Ft. from W. Line;

Elev. 1869

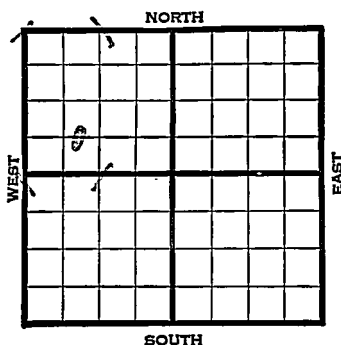

1940	REPORT
8/21	Derrick.
8/29	10" - 499' WOC.
9/5	Anhy 645' SD 2000'
9/12	" " " "
9/19	Drlg. 2875'
9/26	Lens. 3041' Simp. 3318'
	Arb. 3327-30' T.D. 7" - 3327'
	RUST.
10/2	Arb. 3227'
	7" - 3227'
	T.D. 3340'
	1000 acid.
	Depthograph potential 58,467 bbls
	Maximum 3000 bbls.
	COMPLETED

Map No. _____ Sec. 16 Twp. 16 R. 10W

Well No. 3 Boye

I T I O

Company _____

Contractor _____

FIRST REPORT

C E L SW NW

_____ Ft. from N. Line


660 _____ Ft. from S. Line

_____ Ft. from E. Line

990 _____ Ft. from W. Line

STOLTENBERG POOL

SECTION PLAT

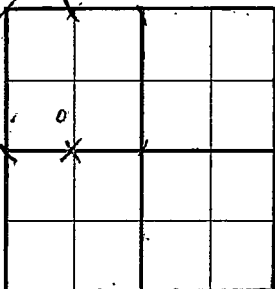

Location _____

Rig up _____

Drilling and Remarks:

Derrick

RECORD

Cased _____ in., _____ ft.

Sand _____

Gas _____

Oil _____

Total Depth _____

PRODUCTION

1st 24 hrs. Nat. _____

1st 24 hrs. after shot _____

Gas _____ Cu. Ft.

Dry Hole _____

Abandoned _____

Date

AUG 21 1940

19

S. J. LEWIS

Scout

Map No. 55 Sec. 16 Twp. 16 R. 10WWell No. 3 Boye

I T I O

Company

Contractor

COMPLETED

C E L SW NW

SECTION PLAT

 Ft. from N. Line660 Ft. from S. Line Ft. from E. Line990 Ft. from W. Line

STOLTENBERG POOL

Location Rig up

Drilling and Remarks:

*Cor 8 3227**7" C 3227**1000 acid**Depth 8 58467**May 3000*

RECORD

Cased in., ft.Sand Gas Oil Total Depth 3340

PRODUCTION

1st 24 hrs. Nat. 1st 24 hrs. after shot Gas Cu. Ft.Dry Hole Abandoned

Date

OCT 2 1940 19S. J. LEWIS Scout