

Cowley

KANSAS

7E

SECTION 11 TOWNSHIP 32 RANGE 7E

WELL NO. #7 Miller

COMPANY Petroleum Management

NORTH

WEST

EAST

	0						

SOUTH

Cowley

KANSAS

SEC. 11	TWP. 32	R. 7E
------------	------------	----------


WELL NO. #7 Miller FARM

COMPANY Petroleum Management

CONTRACTOR Krisswell

School Creek

_____ Ft. from N. Line
 _____ Ft. from S. Line
 _____ Ft. from E. Line
 _____ Ft. from W. Line

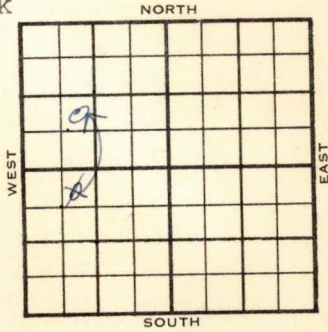

NE NW SW
 Sw NW

1956	ELEVATION 1395'	REPORT
------	--------------------	--------

4-25 Comm. 4-22-56
 8" @ 65
 Drlg. 347

5-23 5 1/2" @ 2180 w/150
 S/ 8 BO / 16 BW 8 hrs., est 65 bopd,
 36/2167-76, tst 1 bwph,
 PB 2160, 32/2138-46, frac
 est P/ 25 bo / 50 bwpd.
 Stall. 1648'. Lay. 2107'.
 TD 2181.

COMPLETED

County Cowley Elev. _____
 Sec. 11 Twp. 32 Rge. 7E
 Company Petroleum Management
 Farm Name Miller No. 7

TOPS	DEPTH	LOG	DATUM	Loc. in Sec.
Anh.				NE NW SW
Tr.				
Dg.				
Bl.				
L.				Geol. _____
K.C.				Contr. _____
B.K.C.				
Ce.				<u>Krisswell</u>
C.				
M.				Pool _____
M.				<u>School Creek</u>
K.				
Mz.				
Ma.				
V.				
S.				
S.				
A.				
R.				
PE.				
G.				
T.D.				

FIRST REPORT
 0
 APR 25 '56

Date Comm. 4-22-56
8" @ 65 drlg. 347

MAY 5 1956

R.O.R


Co.
 Use.
 No.
 Sec.
 T.
 R.

CORRECTION

FORM 513 SUNRAY

County Cowley Elev. 1395
 Sec. 11 Twp. 32 Rge. 7E
 Company Petroleum Management
 Farm Name Miller No. 7

TOPS	DEPTH	LOG	DATUM	Loc. in Sec.
Anh.				NE NW SW- SW NW
Sp. <u>57211</u>	<u>1648</u>			
H. <u>L24</u>	<u>2107</u>			
Tr.				
Dg.				
Bl.				
L.				Geol.
K.C.				
B.K.C.				Contr.
Ce.				<u>Krisswell</u>
C.				
M.				Pool
M.				<u>School Creek</u>
K.				
Mz.				
Me.				
V.				
S.				
S.				
A.				
R.				
PE.				
G.				
T.D.	<u>2181</u>			

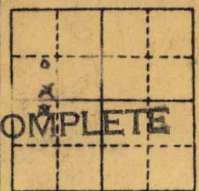

Date Comm. 4-22-56 MAY 23 1956

8" @ 65 drlg. 347 MAY 2 '56 5 1/2 @ 2180

150 MAY 9 '56 MAY 16 '56 CO 2181

\$ 8 B0 + 16 BW 8 hrs

est 65 Bopd MAY 23 '56 36/2167-76

1st 1 Bwph PB 2160 32/

2138-46 Frac. est P. 25

B0 + 50 Bwph.