


Section 35 Township 25 Range 4 E

Well No. # 7⁴ Rice (KGS DRL)

Company Jenson Bros.

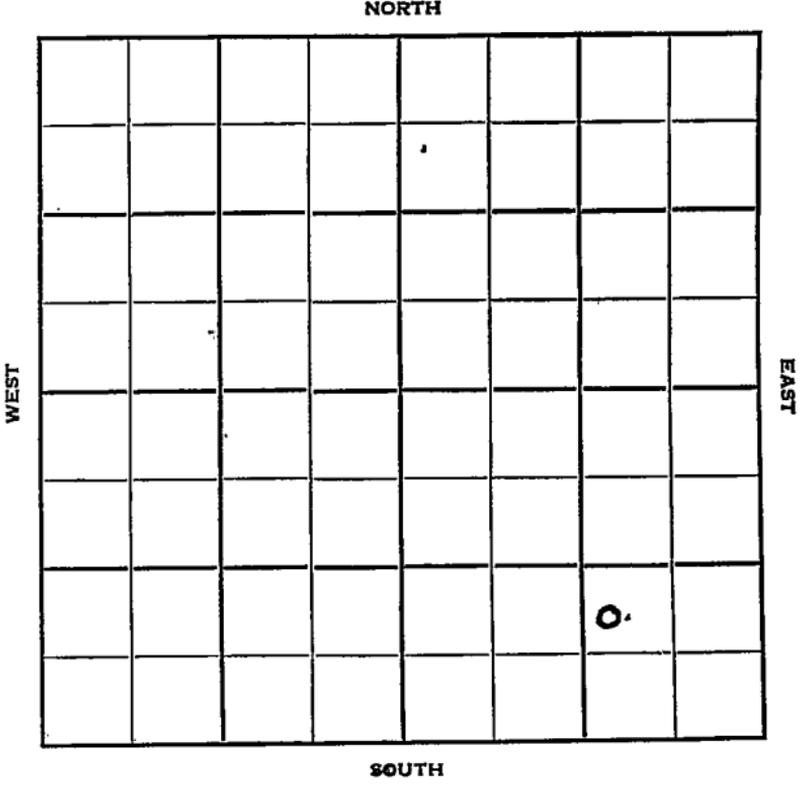

Butler

KANSAS

Sec. 35 Twp. 25 R. 4E

Well No. #1⁴ Rice (KGS DRL) Farm

Jenson Bros. Company

Gox & Burns - Contr. Contractor


_____ Ft. from N. Line

850' Ft. from S. Line

_____ Ft. from E. Line

1500' Ft. from W. Line

NW SE SE

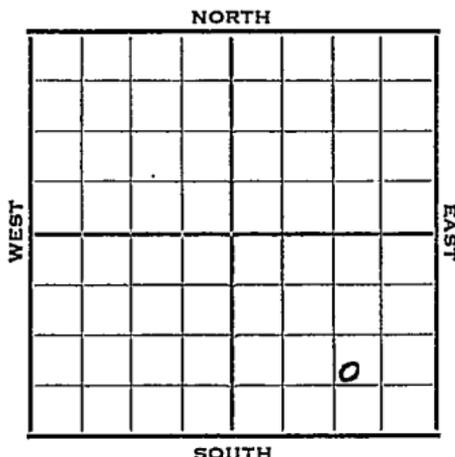

1952 Elv. 1384 REPORT

4/30 Spud 4-2-52
 10" @ 950
 8" @ 1570
 Lans. 1650 KC 1965
 7" @ 2210 Arb. 2409-11
 5" @ 2408 CO DD 2424
 TD fill 200' oil overnight

5/7 Spud 4-2-52
 Oil Well TD 2424' 10" @ 950
 8" @ 1570
 Lans. 1650 KC 1965'
 7" @ 2210 Arb. 2409-11
 5" @ 2408' DD 2424
 FU 200' oil overnite
 Comp. 20 bopd

COMPLETED

