


Section 15 Township 32 Range 7E

Well No. 1 Reedy

Company Kriswell Oil

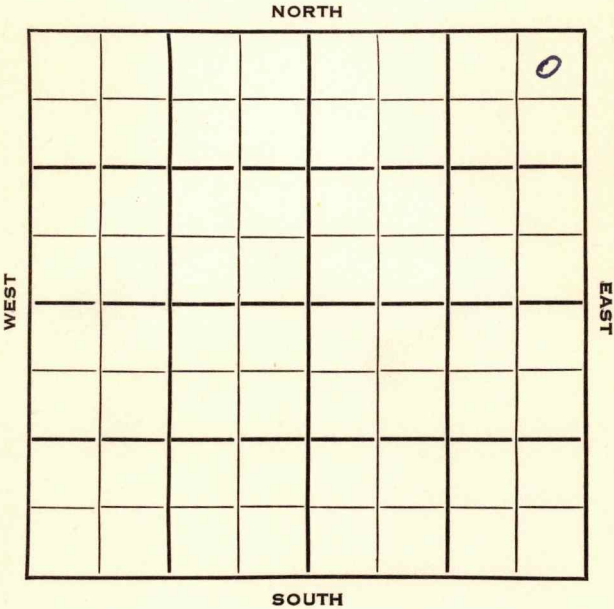

Cowley KANSAS

SEC.	TWP.	R.
15	32	7E

WELL NO.

1 Reedy

FARM

COMPANY

Kriswell Oil

CONTRACTOR

Semi-Wildcat


330 Ft. from N. Line

Ft. from S. Line

330 Ft. from E. Line

Ft. from W. Line

NE NE NE

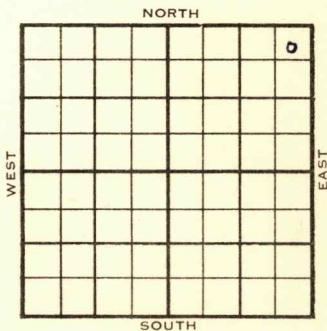

1954

ELEVATION

1346'

REPORT

4/7
5/12

MIR

Spud 4-6-54

8" @ 80'

Layton 2039'

TD 2140'

D & A

ABANDONED

County Cowley State Kansas

Sec. 15 (Blk. Twp.) 32 (Sur. Rge.) 7E Map No.

Operator Kriswell Oil

Well No. 1 Farm Reedy

Elev.	Location
	NE NE NE

0

FIRST REPORT

330 Ft. From N Line NE

330 Ft. From E Line Quarter

1st. Report APR 7 1954

Completion

Remarks

Spudding Date _____

Drlg. Data Semi-Wildcat

M I R

J. G. McGEHEE

County Cowley State Kansas

Sec. 15 (Blk. Twp.) 32 (Sur. Rge.) 7E Map No.

Operator Kriswell Oil

Well No. 1 Farm Reedy

Elev. 1346 Location NE NE NE

3.30 Ft. From N Line NE

330 Ft. From E Line Quarter

1st. Report

Completion **MAY 12 1954**

Remarks Semi Wildcat

Spudding Date 4-6-54

Drlg. Data

8" @ 80 Layton 2039 TD 2140

D & A

J. G. McGEHEE