


KANSAS Butler

Section 35 Township 25 Range 4E

Well No. 2 Rice-Tanner

Company Dunn & Strait

Misc.
NORTH

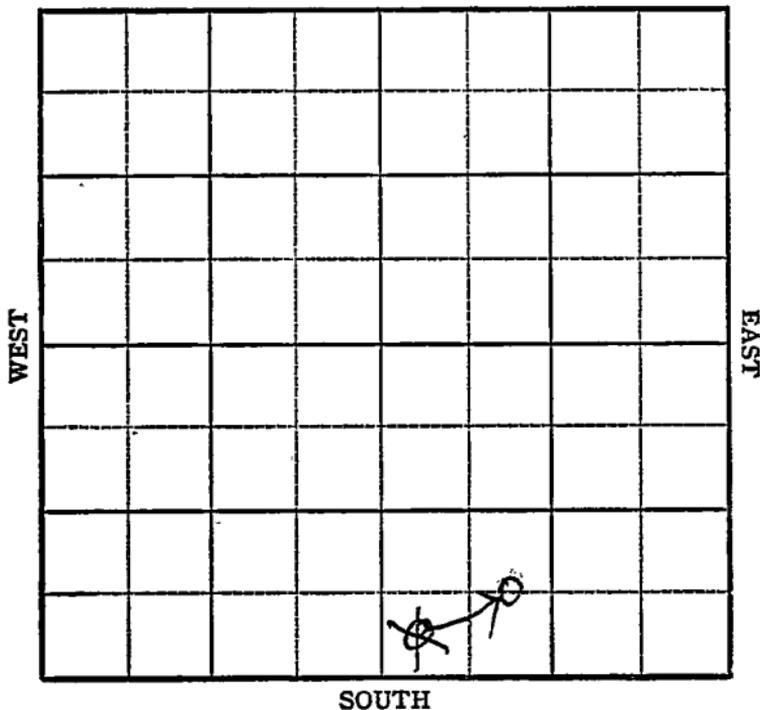

Sec. 35 Twp. 25 R. 4E ✓

Well No. #1 Rice-Tanner Farm

Dunn & Strait Company

Misc.

Ft. from N. Line

660'

Ft. from S. Line

330


Ft. from E. Line

990'

Ft. from W. Line

330

~~SW SE~~ **CEL SW SE**

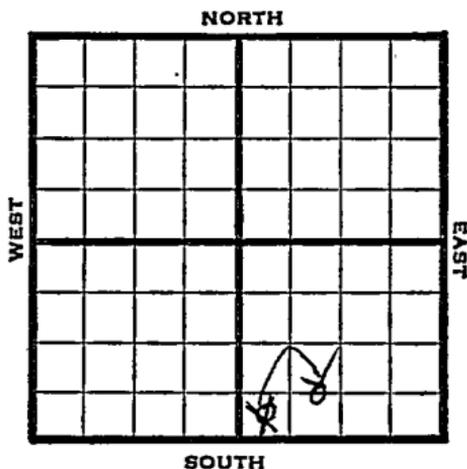

1948

Eli 1375'

REPORT

9/22

8" @ 58'

9/29

Drlg. 1520'

10/6

Arbuckle 2394'

TD 2400'

5" @ 2395'

10/13

TD 2420'

20 qts 2398'-2419'

CO

19/20

TD 2420'

Arb. 2394'

5" @ 2395'

Pump 20 Oil Pot

38° Gr.

Comp

COMPLETED

Butler County Kansas State

Map No. _____ Sec. 35 Twp. 25 R. 4E

Well No. 2 Rice - Tanner

Dunn & Strait Company

FIRST REPORT

Contractor

SW SE

SECTION PLAT

| | | | | | | | |
|--|--|--|--|--|--|--|--|
| | | | | | | | |
| | | | | | | | |
_____ Ft. from N. Line

330 Ft. from S. Line

_____ Ft. from E. Line

330 Ft. from W. Line

Miscellaneous

Remarks:

8" @ 59'

Date
SEP 22 1948

Scout **S. J. LEWIS**

Butler County Kansas State

Map No. 14 Sec. 35 Twp. 25 R. 4E

Well No. 1 Rice - Tanner

Dunn & Strait Company

CORRECTION Contractor

C E L SW SE

SECTION PLAT

 Ft. from N. Line

660 Ft. from S. Line

 Ft. from E. Line

990 Ft. from W. Line

| | | | | | | | |
|--|--|--|--|--|--|--|--|
| | | | | | | | |
| | | | | | | | |
Miscellaneous

Remarks:

Reported as #2 Rice - Tanner in SW SE

Date
SEP 29 1948

Scout
S. J. LEWIS

Map No. 14 Sec. 35 Twp. 25 R. 4E

Well No. 1 Rice - Tanner

Dunn & Strait Company

COMPLETE Contractor

C E L S W S E

E 11375
SECTION PLAT

_____ Ft. from N. Line

660 Ft. from S. Line

_____ Ft. from E. Line

990 Ft. from W. Line

| | | | |
|--|--|--|--|
| | | | |
| | | | |
| | | | |
| | | | |

Butler County

RECORD

Location _____

Cased _____ in., _____ ft.

Rig up _____

Sand _____

Drilling and Remarks:

Gas _____

Cor 2894

Oil

5" @ 2895

Total Depth 2420

PRODUCTION

Prod 20 oil Prod

1st 24 hrs. Nat. _____

1st 24 hrs. after shot _____

Gas _____ Cu. Ft.

Dry Hole _____

Abandoned _____

2895

Date

OCT 20 1948 19

S. J. LEWIS Scout