


Section 35 Township 25 Range 4E

Well No. #1 Rice-Tanner

Company Jensen Bros. et al

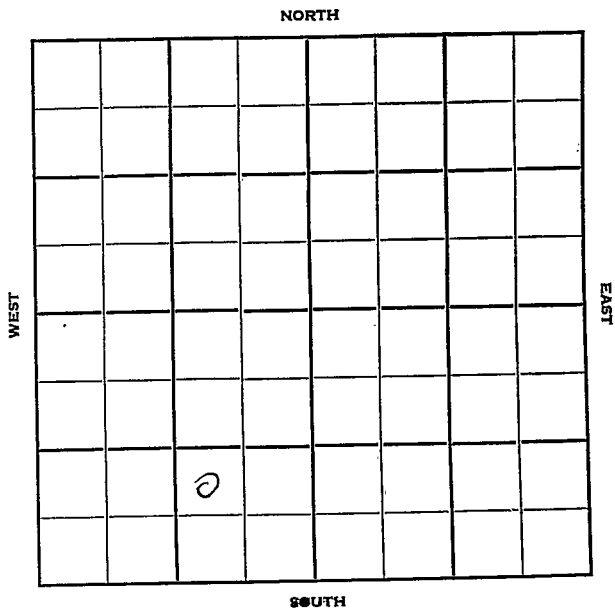

Butler KANSAS

Sec. 35 Twp. 25 R. 4E ✓

Well No. ³ #1 Rice-Tanner Farm

Jensen Bros. et al Company

Martin & Cash - Contr. Contractor


_____ Ft. from N. Line

990' Ft. from S. Line

990' Ft. from E. Line

_____ Ft. from W. Line

NW SE SW

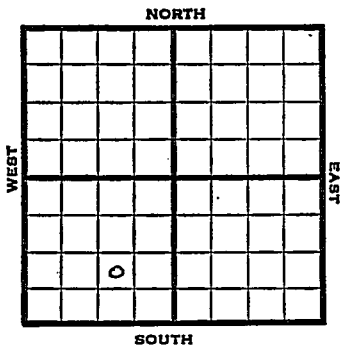

1951

Elev. 1372' REPORT

6/13

Spud 6-9-51
8" @ 60'
SD @ 419

7/18

Spud 6-20-51
Oil Well TD 2438
8" @ 50'
Arb. 2423-27 7" @ 2424
TD 2438 30 qt 2420-38
Comp. 25 bopd

COMPLETED

