

15-063-20363

State Geological Survey  
WICHITA BRANCH  
KANSAS DRILLERS LOG

API No. 15 —————  
County \_\_\_\_\_ Number \_\_\_\_\_

S. 34 T. 15 R. 26W<sup>E</sup>  
Loc. 200' E/SW SW NE  
County \_\_\_\_\_ Gove \_\_\_\_\_

Operator  
Donald C. Slawson

Address  
200 Douglas Building, Wichita, Kansas 67202


Well No. #1 Lease Name Deighton

Footage Location  
2310' feet from (N) ~~XX~~ line 2090' feet from (E) (W) line

Principal Contractor Slawson Drilling Co., Inc. Geologist George Mueller

Spud Date 9/22/77 Total Depth 4575 P.B.T.D. N/A

Date Completed 9/30/77 Oil Purchaser N/A

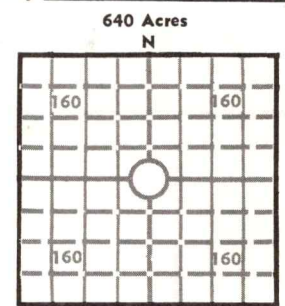

Locate well correctly  
Elev.: Gr. 2558  
DF 2560 KB 2563

CASING RECORD

Report of all strings set — surface, intermediate, production, etc.

Purpose of string	Size hole drilled	Size casing set (in O.D.)	Weight lbs/ft.	Setting depth	Type cement	Sacks	Type and percent additives
Surface	12 1/4"	8 5/8"	28#	250'	60/40 poz	175	2% gel, 3% cc

LINER RECORD

PERFORATION RECORD

Top, ft.	Bottom, ft.	Sacks cement	Shots per ft.	Size & type	Depth interval

TUBING RECORD

Size	Setting depth	Packer set at

ACID, FRACTURE, SHOT, CEMENT SQUEEZE RECORD

Amount and kind of material used	Depth interval treated

INITIAL PRODUCTION

Date of first production \_\_\_\_\_ Producing method (flowing, pumping, gas lift, etc.) \_\_\_\_\_

RATE OF PRODUCTION PER 24 HOURS	Oil	Gas	Water	Gas-oil ratio
	bbls.	MCF	bbls.	CFPB
Disposition of gas (vented, used on lease or sold)			Producing interval (s)	

INSTRUCTIONS: As provided in KCC Rule 82-2-125, within 90 days after completion of a well, one completed copy of this Drillers Log shall be transmitted to the State Geological Survey of Kansas, 4150 Monroe Street, Wichita, Kansas 67209. Copies of this form are available from the Conservation Division, State Corporation Commission, 3830 So. Meridian (P.O. Box 17027), Wichita, Kansas 66217. Phone AC 316-522-2206. If confidential custody is desired, please note Rule 82-2-125. Drillers Logs will be on open file in the Oil and Gas Division, State Geological Survey of Kansas, Lawrence, Kansas 66044.

Operator Donald C. Slawson DESIGNATE TYPE OF COMP.: OIL, GAS, DRY HOLE, SWDW, ETC.: dry hole

Well No. #1 Lease Name Deighton 'A'

S 34 T 15 R 26 W E W


**WELL LOG**

Show all important zones of porosity and contents thereof; cored intervals, and all drill-stem tests, including depth interval tested, cushion used, time tool open, flowing and shut-in pressures, and recoveries.

SHOW GEOLOGICAL MARKERS, LOGS RUN, OR OTHER DESCRIPTIVE INFORMATION.

FORMATION DESCRIPTION, CONTENTS, ETC.	TOP	BOTTOM	NAME	DEPTH
			LOG TOPS	
			ANH 1984 (+579)	
			HEEB 3816 (-1253)	
			TORO 3836 (-1273)	
			LANS 3856 (-1293)	
			STK 4100 (-1537)	
			L/CK 4393 (-1830)	
			MISS 4471 (-1908)	
			LTD 4572 (-2009)	
0 - 255 Surface casing				
255 - 763 Shells and sand				
763 - 1893 Shale and shells				
1893 - 1989 Shale				
1989 - 2024 Anhydrite				
2024 - 2823 Shale				
2823 - 4173 Shale and lime				
4173 - 4490 Lime				
4490 - 4575 Lime and shale				
4575 RTD				
DST #1 4019-50 (140' zn), 30-30-30-30, WB/10", Rec. 10' M, IFP 21-42#, ISIP 1145#, FFP 42-42#, FSIP 1072#				
DST #2 4073-4108 (180' zn) 30-30-30-30, WB/3", Rec. 5' M, IFP 31-42#, ISIP 916#, FFP 42-42#, FSIP 760#				
DST #3 4394-4490 (MISS), 30-45-45-60, W-FB, Rec. 10' CO, 144' SOCM, I/P 73-94#, ISIP 1281#, FFP 94-136#, FSIP 1218#				
DST #4 4490-98 (MISS) WB died/30" 30-45-30-30, Rec. 30' MW w/few spks oil, IFP 21-31#, ISIP 1281#, FFP 31-42#, FSIP 1156#				

USE ADDITIONAL SHEETS, IF NECESSARY, TO COMPLETE WELL RECORD.

Date Received	
	Signature
	R.J. Thatcher
	Title
	October 14, 1977
	Date