


Section 24 Township 25 Range 4E

Well No. #1 ~~JONES~~ RYAN

Company Bennett & Abel etal.

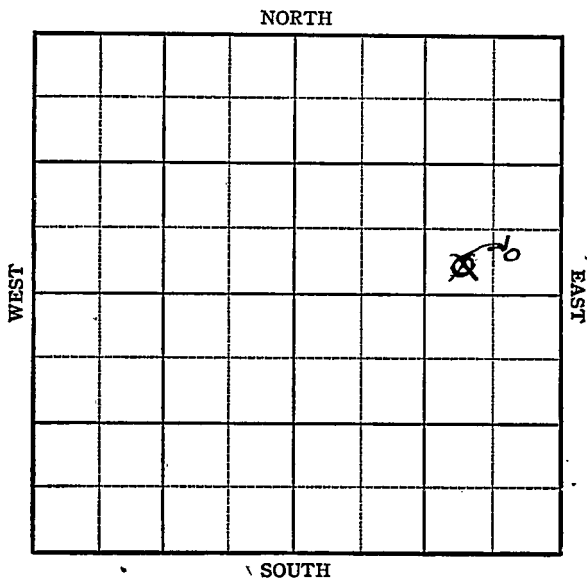


Sec. 24 Twp. 25 R. 4-E

Well No. ~~#1? Jones RYAN #1 Ryan~~ Farm

Bennett & Abel etal Company

NORTH

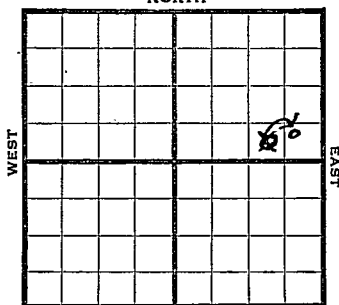

 Ft. from N. Line

470

 Ft. from S. Line

~~330~~

420

 Ft. from E. Line

~~990~~

 Ft. from W. Line

Miscellaneous Elev. 1415

SOUTH

1944

REPORT

- 3/15 Cellar
- 3/22 Machine
- 3/29 "
- 4/5 "
- 4/12 15" @ 225
Drlg. 350
- 4/19 Drlg. 840
- 4/26 12" @ 936
10" @ 1540
Drlg. 1550
- 5/3 8" @ 2105
Drlg. 2150'
- 5/10 Chat 2516-39
TD 5" @ 2535
P.B.P.
- 5/17 Chat. 2516
6" - 2535
Pump 25 - Pot.
Gravity 38.
Total Depth 2573

COMPLETED

KANSAS
 Map No. 74 Sec. 24 Twp. 25 R. 4E

Well No. 1 ?

Bennett & Abel et al. Company

FIRST REPORT

Contractor

SW SE NE

SECTION PLAT

_____ Ft. from N. Line

330 Ft. from S. Line

990 Ft. from E. Line

_____ Ft. from W. Line

			o

Miscellaneous

Location _____

Rig up _____

Drilling and Remarks:

Cellar

RECORD

Cased _____ in., _____ ft.

Sand _____

Gas _____

Oil _____

Total Depth _____

PRODUCTION

1st 24 hrs. Nat. _____

1st 24 hrs. after shot _____

Gas _____ Cu. Ft.

Dry Hole _____

Abandoned _____

Date

MAR 15 1944

19

S. J. LEWIS Scout

KANSAS

Map No. 4 Sec. 24 Twp. 25 R. 4E

Well No. 1 Ryan

Bennett-Abel et al. Company

CORRECTION

Contractor

SE NE

SECTION PLAT

_____ Ft. from N. Line

470 Ft. from S. Line

420 Ft. from E. Line

_____ Ft. from W. Line

Miscellaneous

Location _____

Rig up _____

Drilling and Remarks:

Reported
#1 Jones

*correct spot &
feet measurements
ama.*

RECORD

Cased _____ in., _____ ft.

Sand _____

Gas _____

Oil _____

Total Depth _____

PRODUCTION

1st 24 hrs. Nat. _____

1st 24 hrs. after shot _____

Gas _____ Cu. Ft.

Dry Hole _____

Abandoned _____

Date

APR 12 1944 19

S. J. LEWIS Scout

KANSAS

Pool Name MiscellaneousMap No. 19 Sec. 24 Twp. 25 R. 4EWell No. 1 Jones RyanBennett & Abel et al. Company**COMPLETED**

Contractor

SE NE

SECTION PLAT

_____ Ft. from N. Line

470 Ft. from S. Line420 Ft. from E. Line

_____ Ft. from W. Line

Butler County

Location _____

Rig up _____

Drilling and Remarks:

Ok 25166" @ 2535Pump 25 1/2380 gr

RECORD

Cased _____ in., _____ ft.

Sand _____

Gas _____

Oil _____

Total Depth 2529

PRODUCTION

1st 24 hrs. Nat. _____

1st 24 hrs. after shot _____

Gas _____ Cu. Ft.

Dry Hole _____

Abandoned _____

Date

MAY 17 1944 19

S. J. LEWIS Scout