


Ellsworth

Form 51-5M-11-31-Palace

Map No. **KANSAS** Sec. 16 Twp. 16 R. 10^W

Well No. 2 Kozisek Farm
Gypsum Oil Company

NORTH

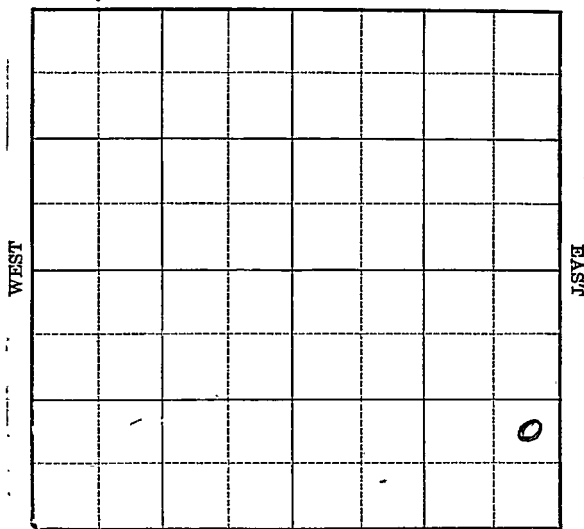

SOUTH

Location _____

Drilling Remarks _____

Rig Up _____

Drilling Remarks _____

RECORD

Cased _____ in. _____ ft.

Sand _____

Gas _____

Oil _____

Total Depth _____

PRODUCTION

1st 24 hrs. Nat. _____

1st 24 hrs. after shot _____

Gas _____ cu. ft.

Dry Hole _____

Abandoned _____

Ellsworth

Map No. **KANSAS** Sec. 16 Twp 16 R. 10 ^W

Well No. 2 Koyisek Farm


Gypsy Oil Company

 Ft. from N. Line

990 Ft. from S. Line

330 Ft. from E. Line

 Ft. from W. Line

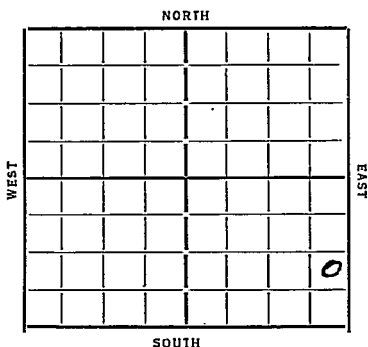

Date 1934

REPORT

5/16 Location
5/25 Bldg.
5/31 Rigging up
6/7 Dlg 1490 20" 305
6/14 15" 510 12" 1080
6/21 Dlg 2100 10" 2015
6/28 2375 Rep engine
7/5 Dlg 2750
7/12 S.B. 2855-60 8" 2975
 Dlg 3310
7/19 7" Oil 3376 6" 3377
 Pay 3389-91 1/2 1300' 3 hrs.
7/26 TD 3393 PB 3392 No test
8/1 Silicious 3376 TD 3393
 PB 3392 200' oil 110' water.

ABANDONED

[Handwritten signature]

KANSAS

Map No. 55 Sec. 16 Twp. 16 R. 10 ^WWell No. 2-HozisekHyge oil Company

Contractor

FIRST REPORTS

SECTION PLAT

			0

____ Ft. from N. Line

990 Ft. from S. Line330 Ft. from E. Line

____ Ft. from W. Line

Location ✓

Rig up _____

Drilling and Remarks:

RECORD

Cased _____ in., _____ ft.

Sand _____

Gas _____

Oil _____

Total Depth _____

PRODUCTION

1st 24 hrs. Nat. _____

1st 24 hrs. after shot _____

Gas _____ Cu. Ft.

Dry Hole _____

Abandoned _____

Date

5-16-37 19JERAL MANN SCHRECK
Scout

Map No. 55 Sec. 16 Twp. 16 R. 10WWell No. 2-KozisekGypsy Oil CompanyABANDONED Contractor

SECTION PLAT

			0

990 Ft. from N. Line330 Ft. from S. Line330 Ft. from E. Line Ft. from W. LineLocation Rig up

Drilling and Remarks:

P.B. 3392500 oil
110 water

RECORD

Cased in., ft.Sand thinness 3376Gas Oil Total Depth 3393

PRODUCTION

1st 24 hrs. Nat. 1st 24 hrs. after shot Gas Cu. Ft.Dry Hole Abandoned

Date

5-1-34 19

ORVAL MANSCHREK

Scout