KANSAS Ellsworth


FORM 51 5M 4-41 PETROL

Section 16 Township 16 Range 10-W

Well No. #1 Malir

Company Jack Robertson et al

Stoltenberg Pool

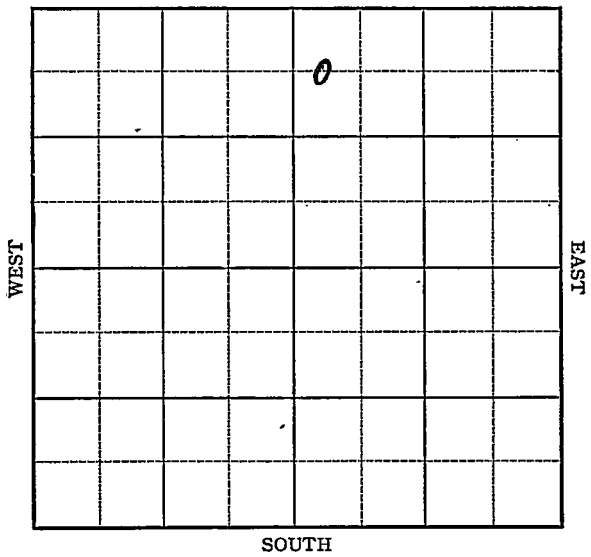

FORM 252-A 5M 6-41 PETROL **KANSAS** Ellsworth

Sec. 16 Twp. 16 R. 10-W

Well No. #1 Malir Farm

Jack Robertson et al Company


(Stoltenberg)

660 Ft. from N. Line

_____ Ft. from S. Line

_____ Ft. from E. Line

330 Ft. from W. Line

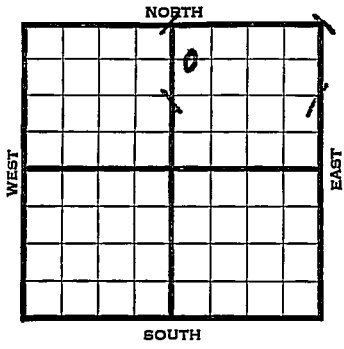


Elev. 1813

| 1941 | REPORT |
|---|---|
| 8/27 | Fishing 110' |
| 9/4 | Fsg. 430' |
| 9/11 | 15" - 325' Anhy 595' |
| | 12" - 598' Drlg. 895' |
| 9/18 | Drlg. 1760' |
| 9/25 | Drlg. 2305' |
| 10/2 | SD 2435' |
| 10/9 | Drlg. 2945' |
| 10/16 | 10" - 1908' 8" - 2410' |
| | Drlg. 3250' |
| | |
| 10/22 | Cong. 3303' H.F.W. |
| | Lans. 2990' |
| | T.D. 3350' |
| | |
| | ABANDONED |

Form 26 200 Bks. 5-41 McW. Ellsworth KANSAS

Map No. _____ Sec. 16 Twp. 16 R. 10W

Well No. 1 Malir

Jack Robertson etal
Company

FIRST REPORT
Contractor

C W L NW NE

660 Ft. from N. Line


_____ Ft. from S. Line

_____ Ft. from E. Line

330 Ft. from W. Line

STOLTENBERG POOL

SECTION PLAT

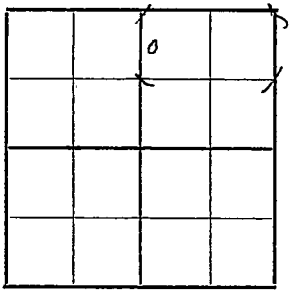

Location _____

Rig up _____

Drilling and Remarks:

Fishing 110'

RECORD

Cased _____ in., _____ ft.

Sand _____

Gas _____

Oil _____

Total Depth _____

PRODUCTION

1st 24 hrs. Nat. _____

1st 24 hrs. after shot _____

Gas _____ Cu. Ft.

Dry Hole _____

Abandoned _____

Date

AUG 27 1941 19 S. I. LEWIS Scout

Form 26 200 Bks. 5-41 McW. Ellsworth KANSAS

Map No. K-55 Sec. 16 Twp. 16 R. 10W

Well No. 1 Malir

Jack Robertson Company

ABANDONED Contractor

C WL NW NE


660 Ft. from N. Line

Ft. from S. Line

Ft. from E. Line

330 Ft. from W. Line

SECTION PLAT

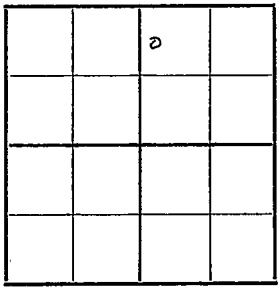

STOLTENBERG POOL

Location

Rig up

Drilling and Remarks:

Conc 3303
H F N.
Lans. 2990

RECORD

Cased in., ft.

Sand

Gas

Oil

Total Depth 3355

PRODUCTION

1st 24 hrs. Nat.

1st 24 hrs. after shot

Gas Cu. Ft.

Dry Hole

Abandoned

Date

OCT 22 1941 19 S. J. LEWIS Scout