


Section 17 Township 16 Range 10-W

Well No. #1 Adamek

Company Duwe & Farris

NORTH Stoltenberg Pool

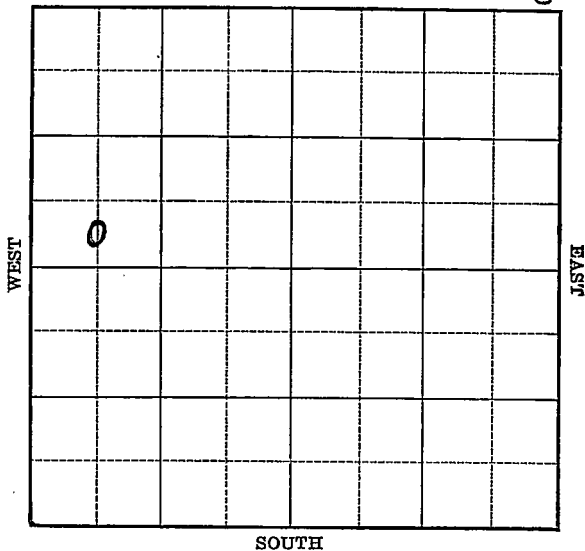

Sec. 17 Twp. 16 R. 10-W

Well No. #1 Adamek Farm

Duwe & Farris Company

(Stoltenberg)


_____ Ft. from N. Line

330 Ft. from S. Line

_____ Ft. from E. Line

660 Ft. from W. Line

Elev. 1905

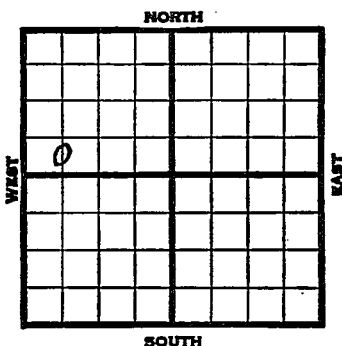

1940	REPORT
2/7	Derrick.
2/15	"
2/23	Surface hole.
2/29	10" - 356' Anhy 710' Drlg. 1670'
3/8	Topeka 2693' Drlg. 2957'
3/14	Lans. 3045' B.K.C. 3315' Drlg. 3365'
3/21	5" - 336 5' RUST.
3/28	Arb. 336 5' T.D. 3366' RUST.
4/4	T.D. 3384' Pump 126 bbls. oil 14 hours.
4/10	Arb. 336 5'
	T.D. 3384'
	1000 acid.
	3000 acid.
	Pump 566 bbls.
	COMPLETED

Map No. 56 Sec. 17 Twp. 16 R. 10W

Well No. 1 Adamek

Duwe & Farris

Company

Contractor

FIRST REPORT

C S $\frac{1}{2}$ SW NW

 Ft. from N. Line

330 Ft. from S. Line

 Ft. from E. Line

660 Ft. from W. Line

STOLTENBERG POOL

SECTION PLAT

Location

Rig up

Drilling and Remarks:

Derrick

RECORD

Cased in., ft.

Sand

Gas

Oil

Total Depth

PRODUCTION

1st 24 hrs. Nat.

1st 24 hrs. after shot

Gas Cu. Ft.

Dry Hole

Abandoned

Date

FEB 7 1940₁₉

S. J. LEWIS Scout

Map No. 55 Sec. 17 Twp. 16 R. 10W

Well No. 1 Adamek

Duwe & Farris Company

Contractor

COMPLETED

SECTION PLAT

C S $\frac{1}{2}$ SW NW

 Ft. from N. Line

330 Ft. from S. Line

 Ft. from E. Line

660 Ft. from W. Line

o			

STOLTENBERG POOL

Location

Rig up

Drilling and Remarks:

1000 acid
3000 acid

Pump 566 bbls.

RECORD

Cased in., ft.

Sand Arbuckle 3365

Gas

Oil

Total Depth 3384

PRODUCTION

1st 24 hrs. Nat.

1st 24 hrs. after shot

Gas Cu. Ft.

Dry Hole

Abandoned

Date

APR 10 1940 19

S. J. LEWIS Scout