

KANSAS


Ellsworth

FORM 51 5M 10-41 PETROL

Section 17 Township 16 Range 10-W

Well No. #1 Horejsi

Company Areo Parts

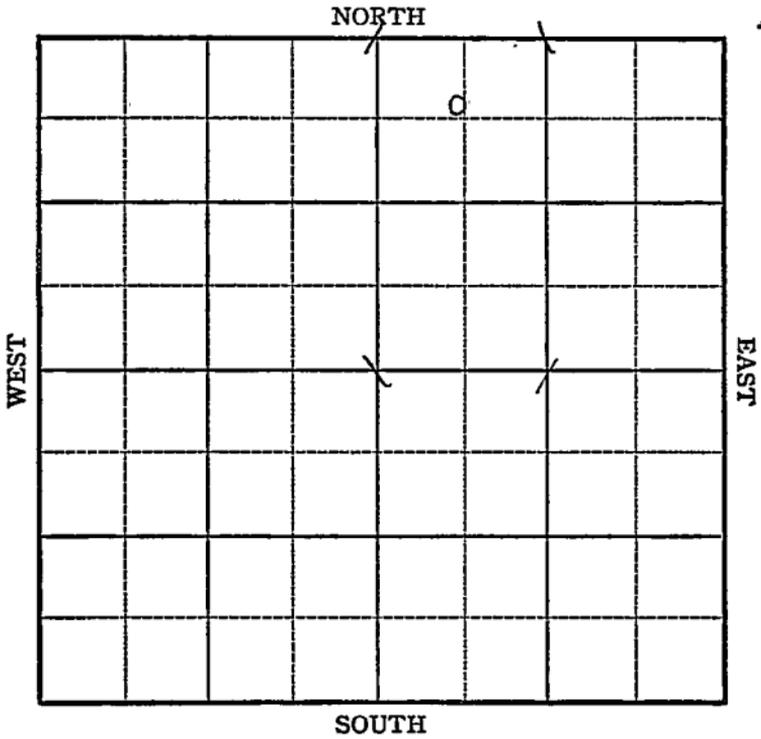

Sec. 17 Twp. 16 R. 10-W

Well No. #1 Horejsi Farm

Areo Parts Company


Stoltemberg

510 Ft. from N. Line

_____ Ft. from S. Line

_____ Ft. from E. Line

510 Ft. from W. Line

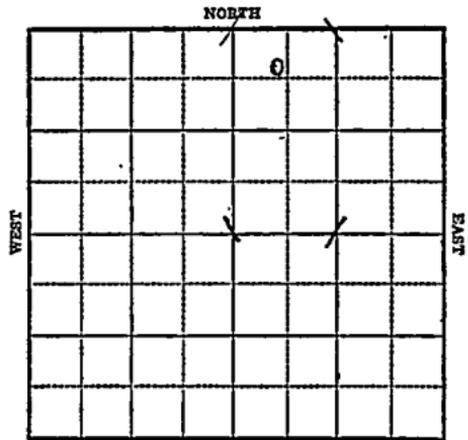

C NW NE 1880 OF 1878 G.V.

R E P O R T

1943

- 2 1/24 Location.
- 3/3 "
- 3/10 Rotary
- 3/16 "
- 3/24 8" @ 373
Drlg. 2100'
- 3/31 Drlg. 2720 Drlg. 2915
- 4/8 Lans 3032
Arb 3357
5" @ 3357
T.D. 3365
5" @ 3357 Rust.
- 4/14 1600' oil in 5 hrs.
- 4/21 1000 acid testing.
- 4/28 Pump 29 oil in 2 1/2 hrs.
- 5/5 " " " " "
- 5/12 " " " " "
- 5/19 " " " " "
- 5/26 Arb. 3357
5" @ 3357'
T.D. 3365'
1000 gal. acid.
Pump 350 Pot.
Gravity 43.9

COMPLETED

Ellsworth

Map No. 55 Sec. 17 Twp. 16 R. 10W

Well No. 1 Horejsi

Area Parts

Company


FIRST REPORT

Contractor

C NW NE

SECTION PLAT

510 Ft. from N. Line

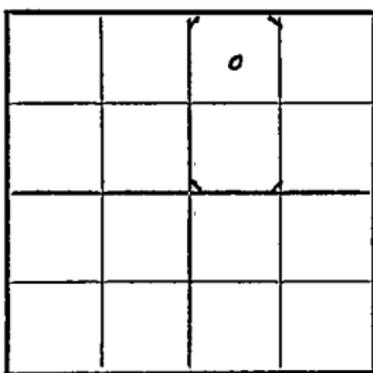

_____ Ft. from S. Line

_____ Ft. from E. Line

510 Ft. from W. Line

STOLTENBERG POOL

Location XXX

RECORD

Rig up _____

Cased _____ in., _____ ft.

Drilling and Remarks:

Sand _____

Gas _____

Oil _____

Total Depth _____

PRODUCTION

1st 24 hrs. Nat. _____

1st 24 hrs. after shot _____

Gas _____ Cu. Ft.

Dry Hole _____

Abandoned _____

Date

FEB 2 4 1943 19

S. J. LEWIS Scout

KANSAS

Map No. 55 Sec. 17 Twp. 16 R. 10W

Well No. 1 Horejsi

Aero Parts Company

COMPLETED Contractor

C NW NE

SECTION PLAT

510 Ft. from N. Line

_____ Ft. from S. Line

_____ Ft. from E. Line

510 Ft. from W. Line

		o	

STOLTENBERG POOL

Location _____

Rig up _____

Drilling and Remarks:

Cor 83357
5103257
1000 acid
Pump 350 ft

439 gr

RECORD

Cased _____ in., _____ ft.

Sand _____

Gas _____

Oil _____

Total Depth 2365

PRODUCTION

1st 24 hrs. Nat. _____

1st 24 hrs. after shot _____

Gas _____ Cu. Ft.

Dry Hole _____

Abandoned _____

Date

MAY 26 1943 19

S. J. LEWIS Scout.