

25

25

Sec. _____ Twp. _____ R. ~~5E~~ 4E

Well No. Ed Adair Farm _____

Ed Adair

Company _____

Miscellaneous

990

_____ Ft. from N. Line


_____ Ft. from S. Line

330

_____ Ft. from E. Line

_____ Ft. from W. Line

NORTH

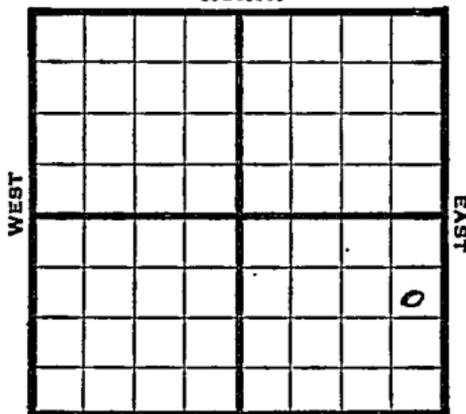

SOUTH

SE NE SE

1947

Elev. 1406

REPORT

5/7

Location

5/28

Sand 695
12" @ 690
Pump 12 Pot
Grav. 38
TD 725'

COMPLETED

Map No. R 14 Sec. 25 Twp. 25 R. 5E

Well No. 1 Girrod


Ed Adair Company

FIRST REPORT Contractor

SE NE SE

SECTION PLAT

990 Ft. from N. Line
 _____ Ft. from S. Line
330 Ft. from E. Line
 _____ Ft. from W. Line

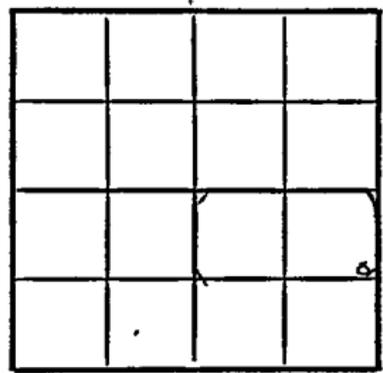

Butler County

Location X
 Rig up _____
 Drilling and Remarks:

RECORD

Cased _____ in., _____ ft.
 Sand _____
 Gas _____
 Oil _____
 Total Depth _____

PRODUCTION

1st 24 hrs. Nat. _____
 1st 24 hrs. after shot _____
 Gas _____ Cu. Ft.
 Dry Hole _____
 Abandoned _____

Date

MAY 7 1947 19 _____

S. J. LEWIS Scout

Map No. K14 Sec. 25 Twp. 25 R. 4E

Well No. 1 Girrod

E. Adair Company

COMPLETE Contractor

SE NE SE

E11406
SECTION PLAT

990 Ft. from N. Line

_____ Ft. from S. Line

330 Ft. from E. Line

_____ Ft. from W. Line

			6

Butler County

Location _____

Rig up _____

Drilling and Remarks:

*Sand 695
12" @ 690*

Pump 12 1/2"

25° SW

RECORD

Cased _____ in., _____ ft.

Sand _____

Gas _____

Oil _____

Total Depth 1725

PRODUCTION

1st 24 hrs. Nat. _____

1st 24 hrs. after shot _____

Gas _____ Cu. Ft.

Dry Hole _____

Abandoned _____

Date

MAY 28 1947 19

S. J. LEWIS

Scout