

KANSAS


Ellsworth

Form 51-5M-7-39-Palace

Section 16 Township 16 Range 10-W

Well No. #1 Malir

Company Gulf

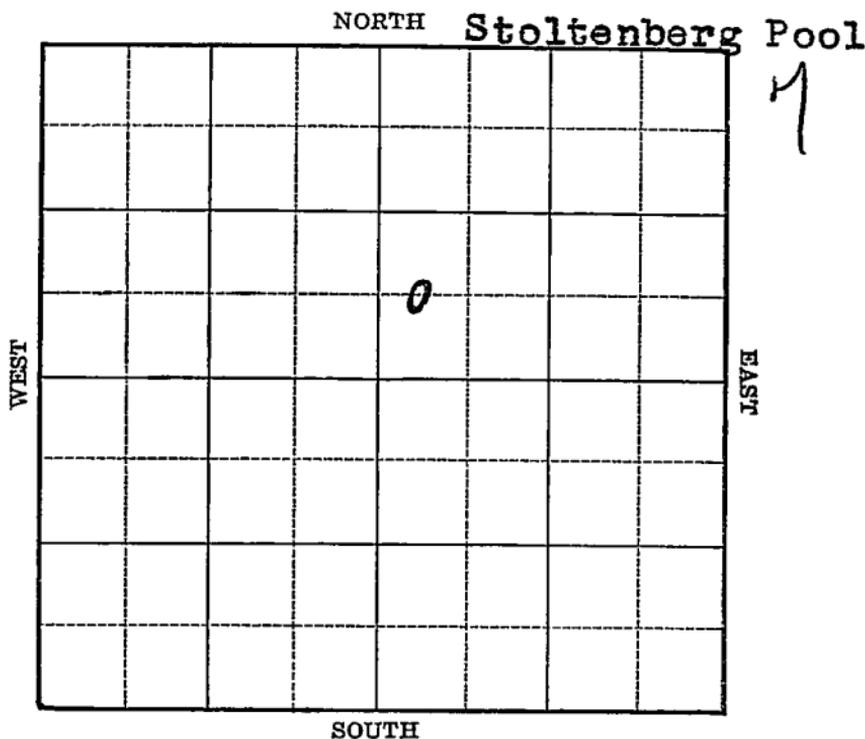

Sec. 16 Twp. 16 R. 10-W

Well No. #1 Malir Farm

Gulf Company

(Stoltenberg)


 Ft. from N. Line

630 Ft. from S. Line

 Ft. from E. Line

300 Ft. from W. Line

Elev. 1832

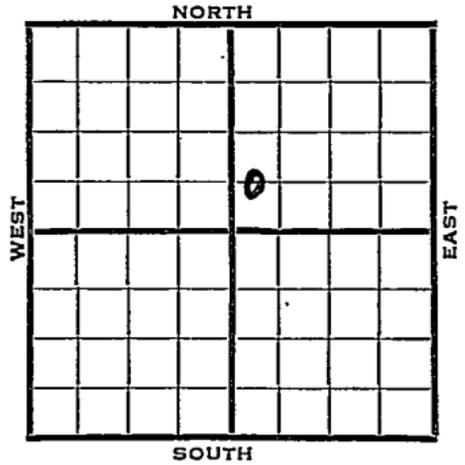

1940	REPORT
4/10	Bldg. rotary derrick.
4/18	8" - 344' Drlg. 1530'
4/25	Drlg. 3211'
5/2	B.K.C. 3280' Simpson 3293'
	Arb. 3317' S.O. 3318-21'
	T.D. 3322' 3100' oil 1 hour.
5/9	" " " " "
5/15	Arb. 3317'
	5" - 3318'
	T.D. 3322'
	Sonimeter potential 7256 bbls.
	Maximum 3000 bbls.
	COMPLETED

Map No. 55 Sec. 16 Twp. 16 R. 10W

Well No. 1 Malir

Gulf

Company

Contractor

FIRST REPORT

Approx.

C W L SW NE

_____ Ft. from N. Line

630 Ft. from S. Line

_____ Ft. from E. Line

300 Ft. from W. Line

STOLTENBERG POOL

SECTION PLAT

		○	

Location _____

Rig up _____

Drilling and Remarks:

Bldg. Roty Derrick

RECORD

Cased _____ in., _____ ft.

Sand _____

Gas _____

Oil _____

Total Depth _____

PRODUCTION

1st 24 hrs. Nat. _____

1st 24 hrs. after shot _____

Gas _____ Cu. Ft.

Dry Hole _____

Abandoned _____

Date

APR 10 1940

S. J. LEWIS

Scout

Map No. 58 Sec. 16 Twp. 16 R. 10W

Well No. 1 Malir

Gulf Company

Contractor

COMPLETED

SECTION PLAT

C W L SW NE

_____ Ft. from N. Line

630 Ft. from S. Line

_____ Ft. from E. Line

300 Ft. from W. Line

STOLTENBERG POOL

Location _____

Rig up _____

Drilling and Remarks:

Ar & 3317

5" C 3318

Sonicmeter 3318
7256.

Maximum 3000

RECORD

Cased _____ in., _____ ft.

Sand _____

Gas _____

Oil _____

Total Depth 3322

PRODUCTION

1st 24 hrs. Nat. _____

1st 24 hrs. after shot _____

Gas _____ Cu. Ft.

Dry Hole _____

Abandoned _____

Date

MAY 15 1940 19

S. J. LEWIS Scout