

KANSAS

Form 51-5M-7-40-Palace


Ellsworth

Section 17 Township 16 Range 10-W

Well No. #2 Adamek

Company H. V. Elwell

NORTH Stoltenberg Pool

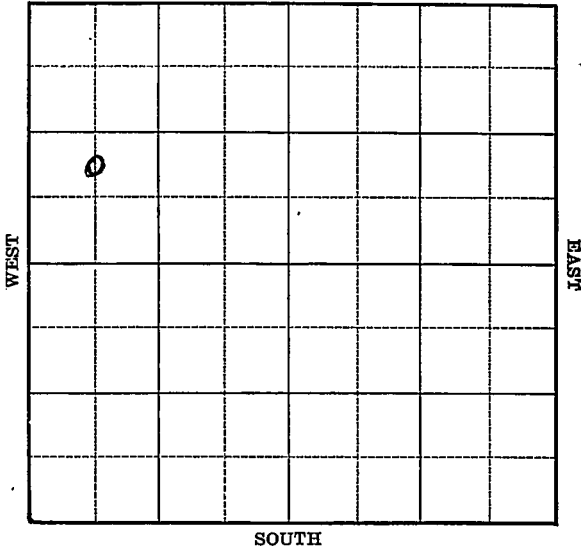

Sec. 17 Twp. 16 R. 10-W

Well No. #2 Adamek Farm

H. V. Elwell Company

(Stoltenberg)


_____ Ft. from N. Line

990 Ft. from S. Line

_____ Ft. from E. Line

660 Ft. from W. Line

Elev. 1917

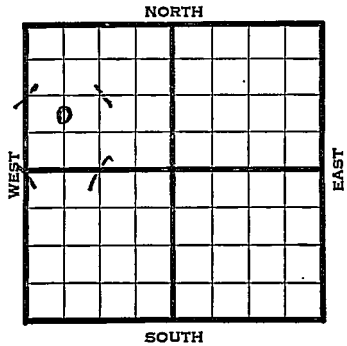

1941	REPORT
3/26	Derrick.
4/2	8" - 374' Drilg. 1645'
4/10	Anhy 718' Drilg. 3030'
4/18	Lans. 3056' Arb. 3372'
	7" - 3379' Pav 3391-92'
	125' oil. 1000 acid.
4/24	T.D. 3292' 600' oil 24 hours.
5/1	500 acid. Pump 20 bbls. oil
	per hour 30 hours.
5/7	Arb. 3372'
	7" - 3379'
	T.D. 3292'
	500 acid.
	Depthograph potential 1193 bbls.
	44. Gravity
	COMPLETED

Map No. 55 Sec. 17 Twp. 16 R. 10W

Well No. 2 Adamek

H. V. Elwell Company

COMPLETED Contractor

C N L SW NW

SECTION PLAT

_____ Ft. from N. Line

990 Ft. from S. Line

_____ Ft. from E. Line

660 Ft. from W. Line

o			

STOLTENBERG POOL

Location _____

Rig up _____

Drilling and Remarks:

*Cr 83372 -
2" 83379
500 cu ft
Depth 8' 1193*

#40 Gal

RECORD

Cased _____ in., _____ ft.

Sand _____

Gas _____

Oil _____

Total Depth 8392

PRODUCTION

1st 24 hrs. Nat. _____

1st 24 hrs. after shot _____

Gas _____ Cu. Ft.

Dry Hole? _____

Abandoned _____

Date

MAY 7 1941 19

S. J. LEWIS Scout