


Section 17 Township 16 Range 10-W

Well No. #3 Adamek

Company H.B. Elwell

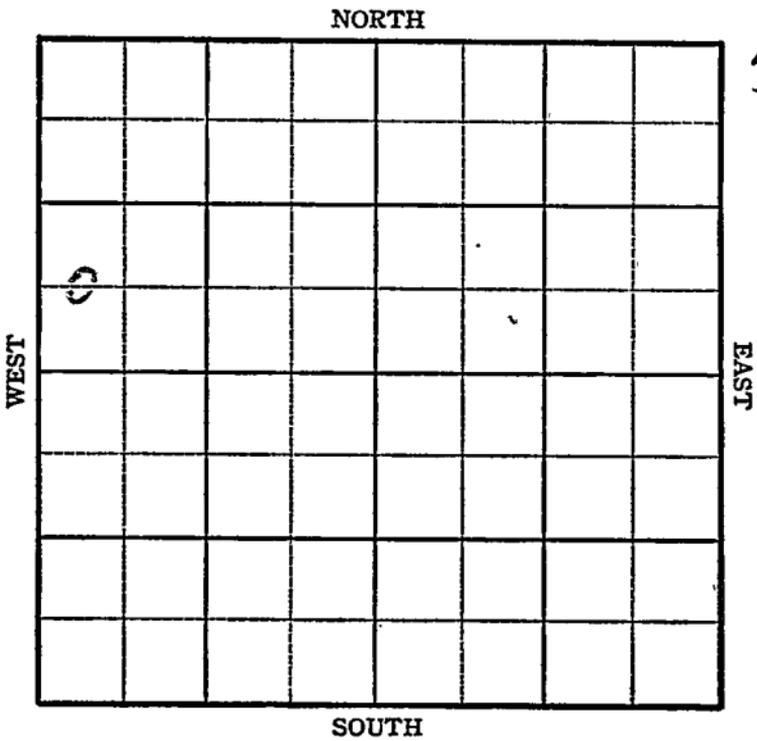

Sec. 17 Twp. 16 R. 10-W


Well No. #3 Adamek Farm
H. B. Elwell Company

 Ft. from N. Line

660 Ft. from S. Line

 Ft. from E. Line

330 Ft. from W. Line

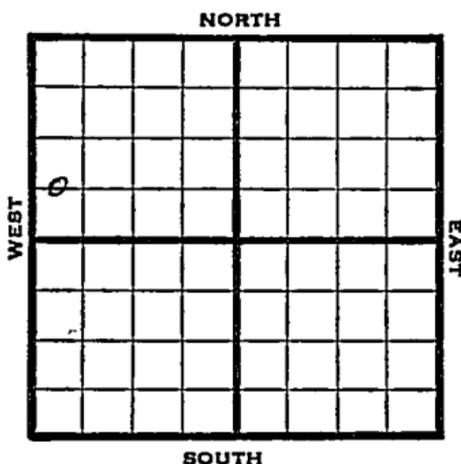

C W L SW NW

1945 Elev. 1914' REPORT

12/5 Location

12/12 RUR

12/20 12" - 352' Anhy 715'

Drlg. 763'

12/29 Drlg. 2700'

1946

1/9 Arb. 3398

TD 3515'

ABANDONED

KANSAS Pool Name Stoltenberg

Map No. K-53 Sec. 17 Twp. 16 R. 10W

Well No. 3 Adamek

H. B. Elwell Company

FIRST REPORT Contractor

C W L SW NW

SECTION PLAT

 Ft. from N. Line

660 Ft. from S. Line

 Ft. from E. Line

330 Ft. from W. Line

| | | | |
|---|--|--|--|
| | | | |
| | | | |
| 0 | | | |
| | | | |
| | | | |

Ellsworth County

Location XX

Rig up

Drilling and Remarks:

RECORD

Cased in., ft.

Sand

Gas

Oil

Total Depth

PRODUCTION

1st 24 hrs. Nat.

1st 24 hrs. after shot

Gas Cu. Ft.

Dry Hole

Abandoned

Date

DEC 5 1945 19

S. J. LEWIS Scout

KANSAS

Pool Name Stoltenberg

Map No. 35 Sec. 17 Twp. 16 R. 10W

Well No. 3 Adamek

H.B. Elwell

Company

ABANDONED

Contractor

C W L SW NW

E.I. 1914
SECTION PLAT

_____ Ft. from N. Line

660 Ft. from S. Line

_____ Ft. from E. Line

330 Ft. from W. Line

| | | | |
|---|--|--|--|
| | | | |
| 0 | | | |
| | | | |
| | | | |

Ellsworth County

Location _____

Rig up _____

Drilling and Remarks:

See 3398

RECORD

Cased _____ in., _____ ft.

Sand _____

Gas _____

Oil _____

Total Depth 95.5

PRODUCTION

1st 24 hrs. Nat. _____

1st 24 hrs. after shot _____

Gas _____ Cu. Ft.

Dry Hole _____

Abandoned _____

Date

JAN 9 1946 19 S. J. LEWIS Scout