


KANSAS

Company Brooks Pierce

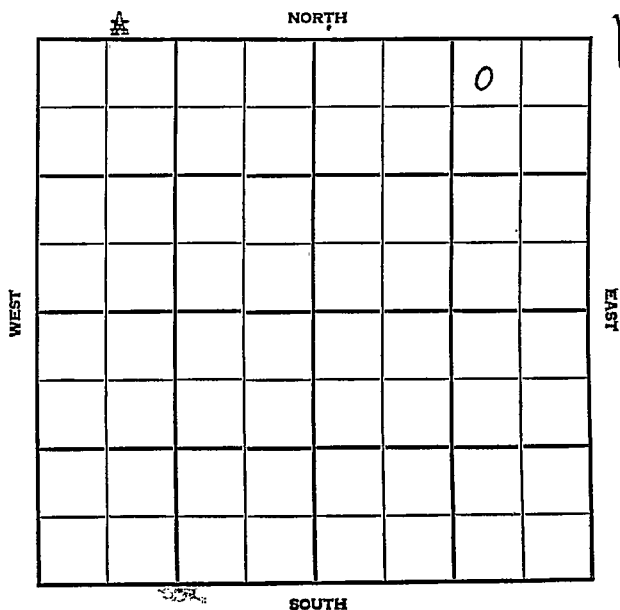

Ellsworth

KANSAS

SEC.

TWP.

R.

17

16

10 W

WELL NO.

1 Horejsi

FARM

COMPANY

Brooks Pierce

CONTRACTOR

Anschutz

Stoltenberg Pool

330 Ft. from N. Line


Ft. from S. Line

990 Ft. from E. Line

Ft. from W. Line

NW NE NE

NORTH

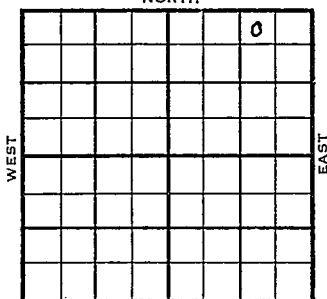

SOUTH

ELEVATION

REPORT

1954

1889'

5/19

MIR

5/26

8" @ 350' Lans. 3030' Arb. 3362'

RTD 3367

5" @ 3362

6/2

WOCT

6/9

Spud 5-17-54 D & A TD 3378

8" @ 350' Lans 3030' Arb. 3362

TD 3367 5" @ 3362 DD 3372 250 A

DD 3378 HFW

D & A

ABANDONED

County **Ellsworth** State **Kansas**

Sec. **17** (Blk. Twp.) **16** (Sur. Rge.) **10W** Map No.

Operator **Brooks Pierce**

Well No. **1** Farm **Eoreisi**

Elev.	Location	NW	NE	NE
-------	----------	----	----	----

0

FIRST REPORT

330 Ft. From N Line NE

990 Ft. From ~~7~~ Line Quarter1st. Report **MAY 19 1954**

Completion


Remarks

Anschutz - Contr.

Spudding Date _____

Dr. Data Stoltenberg Pool

MIR

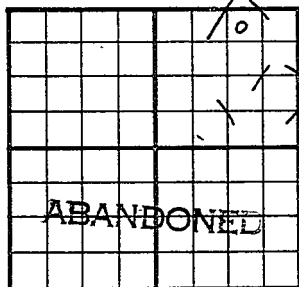County Ellsworth State KansasSec. 17 (Blk. Twp.) 16 (Sur. Rge.) 10W Map No.Operator Brooks PierceWell No. 1 Farm HorejsiElev. 1889 Location NW NE NE330 Ft. From N Line NE990 Ft. From E Line Quarter

1st. Report

Completion JUN 9 1954Remarks Stoltenberg Pool
Anschutz - Contr.Spudding Date 5-17-54Drilg. Data D & A TD 33788" @ 350 Lans. 3030 Arb. 3362TD 3367 5" @ 3362 DD 3372 250 ADD 3378 HFWD & A