


Butler

KANSAS

SECTION 26 TOWNSHIP 25S RANGE 4E

WELL NO. #1 Murray

COMPANY Fultz & Cates

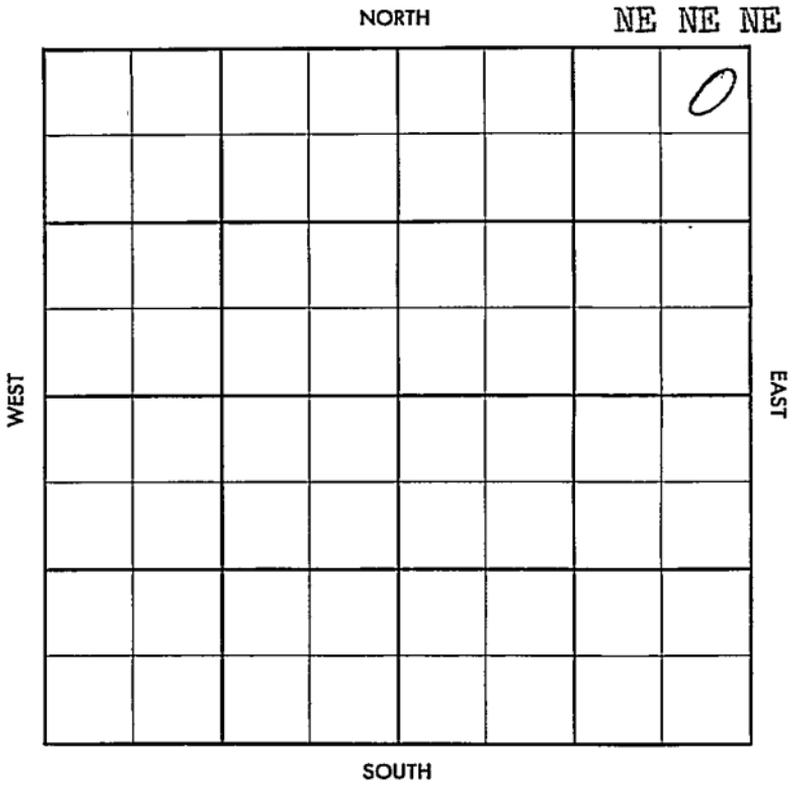

26

FORM 513 SUNRAY

County ~~Butler~~ Elev. 1355 DF

Sec. 26 Twp. 25S Rgs. 4E

Company Fultz & Gates

Farm Name Murray No. 1

TOPS	DEPTH	LOG	DATUM
Anh.			
Tr.			
H.			
Tr.			
Dg.			
Bl.			
L.			
K.C.			
B.K.C.			
Ce.			
C.			
M.			
M.			
K.			
Mz.			
Mq.			
V.			
S.			
S.			
A.			
R.			
Pc.			
G.			
T.D.			

Loc. in Sec. NE NE NE

Geol. _____

Contr. _____

Pool EL Dorado

FIRST REPORT

SEP 1 1957

Date Comm. _____

Surface casing set 150' Location _____

Co. Lse. No. Sec. T. R.

County Butler

Elev. 1355 DF

Sec. 26 Twp. 25S

Rge. 4E

Company Fultz & Gates

Farm Name Murray

No. 1

Co.

Sec.

No.

Sec.

T.

R.


TOPS	DEPTH	LOG	DATUM
Anh <u>Sh Sl</u>	<u>711.26</u>		
Ip.			
H.			
Tr.			
Dg.			
Bl.			
L.			
K.C.			
B.K.C.			
Ce.			
C.			
M.			
M.			
K.			
Mz.			
Me.			
V.			
S.			
S.			
A.			
R.			
PE.			
G.			
T.D.	<u>836</u>		

Loc. in Sec. NE NE NE

Geol. _____

Contr. _____

Pool Eldorado

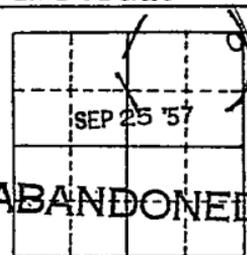

ABANDONED

Date Comm.

Surface casing set 150' Location SEP 18 '57

SEP 25 '57 15-57 8" 136

D & A