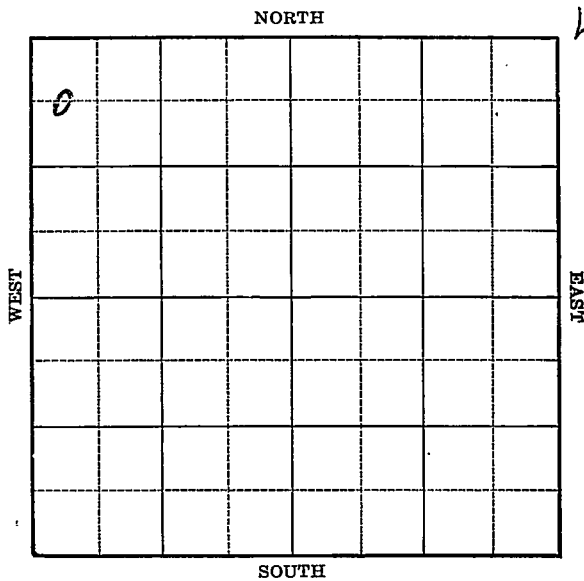


KANSAS

Ellsworth

Form 51-5M-7-40-Palace


Section 17 Township 16 Range 10-WWell No. #1 HorejsiCompany Magnolia

Sec. 17 Twp. 16 R. 10-WWell No. #1 Horejsi FarmMagnolia Company

(Stoltenberg)

660 Ft. from N. Line Ft. from S. Line Ft. from E. Line330 Ft. from W. Line

Elev. 1889

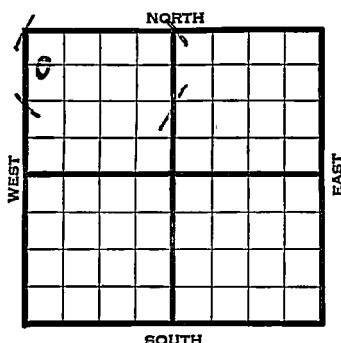

	REPORT
1940	
9/11	Spud 100'
9/19	10" - 362'
	Drlg. 1845'
9/26	Lans. 3043'
	Drlg. 3265'
10/3	Arb. 3364' 5" - 3367'
	Drlg. 3378' 1 gal. water, no oil.
10/10	Shot 15 qts. 3372-78'
	1500 acid. Swab 21 oil & 33 water 6 hours.
10/17	Pump 79 oil & 151 water 24 hrs.
10/23	Arb. 3364'
	5" - 3367'
	T.D. 3378'
	Shot 15 qts. 3372-78'
	15 acid.
	Pump 79 oil & 151 water.
	COMPLETED

Map No. 55 Sec. 17 Twp. 16 R. 10WWell No. 1 HorejsiMagnolia Company

Contractor

FIRST REPORT

C W L NW NW

660 Ft. from N. Line Ft. from S. Line Ft. from E. Line330 Ft. from W. Line**STOLTENBERG POOL****SECTION PLAT**

0			

Location Rig up

Drilling and Remarks:

Spud 100'

RECORDCased in., ft.Sand Gas Oil Total Depth **PRODUCTION**1st 24 hrs. Nat. 1st 24 hrs. after shot Gas Cu. Ft.Dry Hole Abandoned

Date

SEP 11 1940 19S. J. LEWIS Scout

Map No. 55 Sec. 17 Twp. 16 R. 10WWell No. 1 HorejsiMagnolia Company

Contractor

COMPLETED

C W L NW NW

660 Ft. from N. Line

Ft. from S. Line

Ft. from E. Line

330 Ft. from W. Line

STOLTENBERG POOL

SECTION PLAT

0			

Location

Rig up

Drilling and Remarks:

*Cr 83864**5" 83367**10 g to 3872-78**15 a oil**Pump 79 oil 151 Water***RECORD**

Cased _____ in., _____ ft.

Sand _____

Gas _____

Oil _____

Total Depth 3378**PRODUCTION**

1st 24 hrs. Nat. _____

1st 24 hrs. after shot _____

Gas _____ Cu. Ft.

Dry Hole _____

Abandoned _____

Date

OCT 2 1940S. J. LEWIS Scout