


Ellsworth

KANSAS

Section 17 Township 16 Range 10-W

Well No. 1 Horejsi

Company Phillips Petroleum

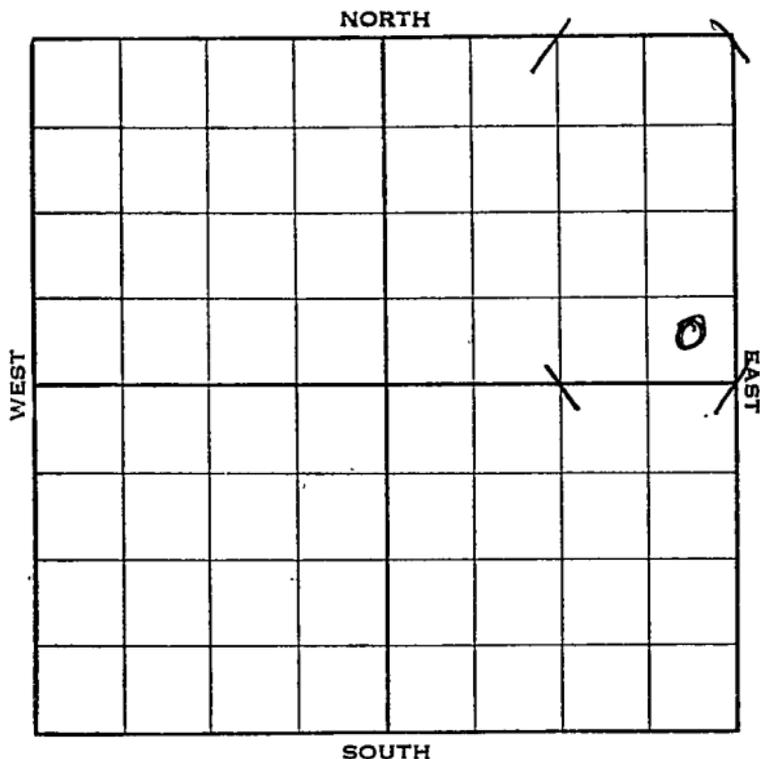

Sec. 17 Twp. 16 R. 10-W

Well No. #1 Horejsi Farm
Phillips Petr. Company


 Ft. from N. Line

330 Ft. from S. Line

330 Ft. from E. Line

 Ft. from W. Line

Elev. 1898

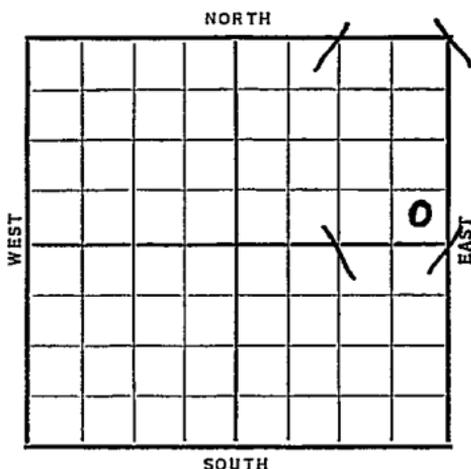

Date

REPORT

1938

7/27

Location

8/5

R. R.

8/12

10" - 380'. WOC.

8/19

Anhy. 675'. Dlg. 2455'.

8/26

Lans. 3065'. Dlg. 3170'.

9/2

Arb. 3365-66'. 7" - 3365'.

RUST.

9/9

T.D. 3380'. Swab 1 bbl. oil per hour.

9/16

500 acid. Swab 175 oil in 12 hours.

9/23

T.D. 3380'. Set unit.

9/28

7" at 3365'.

Arb. 3365'.

T. D. 3380'.

500 acid.

Potential 164 bbls.

COMPLETED

Map No. 55 Sec. 17 Twp. 16 R. 10W

Well No. 1 Horejsi

Phillips Petroleum Company

Contractor

FIRST REPORT

SE NE

_____ Ft. from N. Line

330 Ft. from S. Line

330 Ft. from E. Line

_____ Ft. from W. Line

SECTION PLAT

Location X

Rig up _____

Drilling and Remarks:

RECORD

Cased _____ in., _____ ft.

Sand _____

Gas _____

Oil _____

Total Depth _____

PRODUCTION

1st 24 hrs. Nat. _____

1st 24 hrs. after shot _____

Gas _____ Cu. Ft.

Dry Hole _____

Abandoned _____

Date

JUL 27 1938 19

H. D. Hatfield

Scout

Ellsworth KANSAS

Map No. 55 Sec. 17 Twp. 16 R. 10WWell No. 1 HorejsiPhillips Petroleum Company

Contractor

COMPLETED

SE NE

 Ft. from N. Line330 Ft. from S. Line330 Ft. from E. Line Ft. from W. Line

SECTION PLAT

			0

Location Rig up

Drilling and Remarks:

500 AcidPOT 164

RECORD

Cased 7 in., 3365 ft.Sand ARB 3365Gas Oil Total Depth 3380

PRODUCTION

1st 24 hrs. Nat. 1st 24 hrs. after shot Gas Cu. Ft.Dry Hole Abandoned

Date

SEP 28 1938 19H. D. Hatfield Scout