


Section 17 Township 16 Range 10 W

Well No. #1 Horejsi

Company Currier Et al

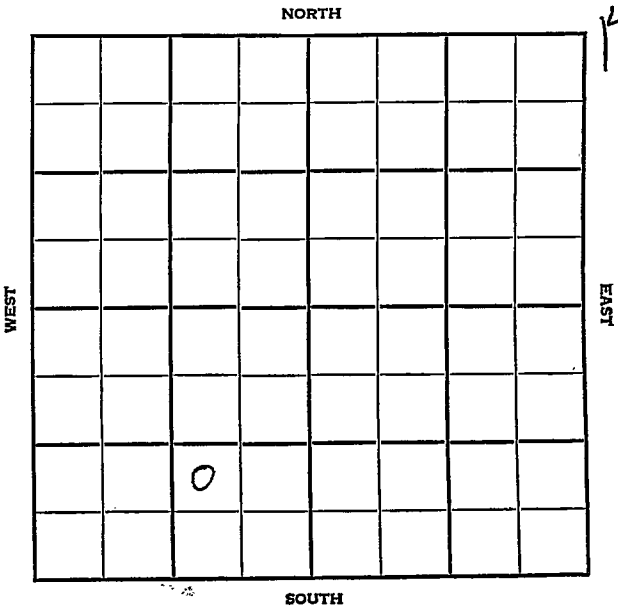

Ellsworth

KANSAS

SEC. 17	TWP. 16	R. 10W
------------	------------	-----------

WELL NO.

#1 Horejsi

FARM

COMPANY

Currier et al

CONTRACTOR

Sterling

Stoltenberg


_____ Ft. from N. Line

_____ Ft. from S. Line

_____ Ft. from E. Line

_____ Ft. from W. Line

NW SE SW

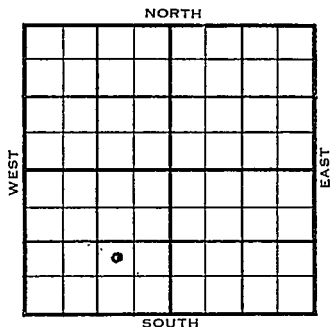

1955

ELEVATION

1892'

RE FIRST REPORT

8/10

Comm: 8-7-55

8" @360/175 WOC

9-14

DST 3362-66 op 30" rec. 30' dm, BHP 770# 20";

DST 3361-80 op 1 hr. rec. 120' gip, rec. 60' smo, 90' gsy oil, 180' frggy oil, BHP 850# 20";

5 1/2" 3380;

CO 3379; 39/3363-76; 50 gal acid; fill 225' oil 9 hrs. ; swb 8 goph no wtr.;

250 A; swb 15 goph no wtr. 4 hrs.;

1000 A; swb 16 goph no wtr.; 2000 A;

swb 3 boph no wtr.:

pmp 43 bopd trc wtr.

Tops: H. 2938

L. 3039

A 3360

T.D. 3380'

COMPLETED

County Ellsworth Elev. _____
 Sec. 17 Twp. 16 Rge. 10W
 Company Currier et al.
 Farm Name Korejsi No. 1

TOPS	DEPTH	LOG	DATUM
Anh.			
Tp.			
H.			
Tr.			
Dg.			
Bl.			
L.			
K.C.			
B.K.C.			
Ce.			
C.			
M.			
M.			
K.			
Mz.			
Me.			
V.			
S.			
S.			
A.			
R.			
PE.			
G.			
T.B.			

Loc. in Sec. NW SE SW
 Geol. _____
 Contr. Sterling
 Pool Stoltenberg

AUG 10 '55
 FIRST REPORT

Date Comm. 8-7-55
8" @ 360/175 WOC

72

Co.
Lse.
No.
Sec.
T.
R.

County	Ellsworth	Elev.	1892
Sec.	17	Twp.	16S
Company	Gurrier et al	Rge.	LOW
FarmName	Horejsi	No.	1

TOPS	DEPTH	LOG	DATUM	Loc. in Sec.
Anh.				NW SE SW
Tr.				
H.	2938		1046	
Dg.				
BL.				
L.	3039		1147	Geol.
K.C.				Contr.
B.K.C.				Sterling
Ce.				Pool
C.				Stoltenberg
M.				
M.				
K.				
Mz.				
Mq.				
V.				
S.				
S.				
A.	3360		1168	COMPLETE
R.				
PE.				
G.				
T.D.	3380			

Date Comm. 8-7-55 SEP 14 1955

8" 360 w/175; DST 3362-66 op 30" rec. 30'
 dm, BHP 770# 20"; DST 3361-80 op 1 hr. rec.
 120' gip, rec. 60' smo, 90' gsy oil,
 180' frggy oil, BHP 850# 20"; 5 1/2" 3380;
 CO 3379; 39/3363-76; 50 gal acid; fill 225'
 oil 9 hrs.; swb 8 goph no wtr.; 250A; swb
 15 goph no wtr. 4 hrs.; 1000 A; swb 16 goph
 no wtr.; 2000 A; swb 3 boph no wtr.;
 pmp 43 bopd tre. wtr.