


Ellsworth KANSAS

Section 17 Township 16 Range 10-W

Well No. #2 Horejsi

Company Phillips Petroleum

NORTH Stoltenberg Pool

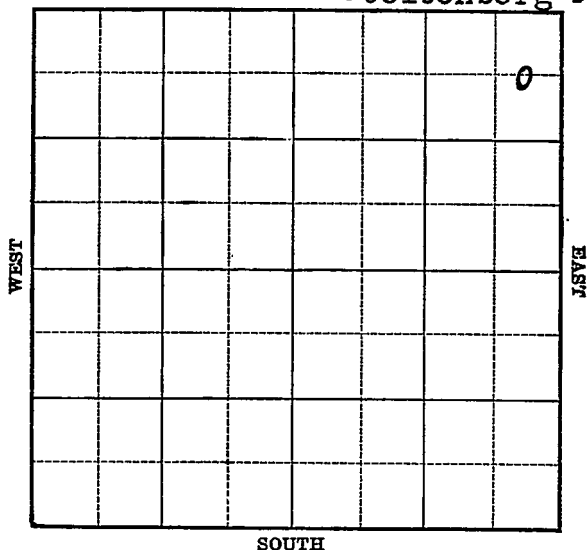

Elsworth

Sec. 17 Twp. 16 R. 10-W

Well No. #2 Horejsi Farm _____

Phillips Petr. _____ Company


(Stoltenberg)

660 Ft. from N. Line

_____ Ft. from S. Line

330 Ft. from E. Line

Ft. from W. Line

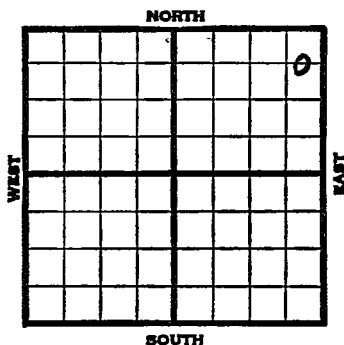

1940	REPORT
2/21	Location
2/29	"
3/8	"
3/14	8" - 476' WOC.
3/21	Anhv 690' Drlg. 2890'
3/28	Arb. 3389' T.D. 3394½'
	5" - 3389' RUST.
4/4	Bailing.
4/12	3394½' 1000 acid. No free oil.
4/18	" " " " " "
4/25	T.D. 3400' 500 acid.
	Pump 11 bbls. per hour 11 hrs.
	3% water.
5/2	Testing.
5/9	"
	OVER

1940

5/15

Arb. 3389'

5" - 3389'

T.D. 3400'

500 acid.

Potential 499 bbls., pump.

COMPLETED

Map No. 53 Sec. 17 Twp. 16 R. 10WWell No. 2 HorejsiPhillips Petroleum Company

Contractor

FIRST REPORT

C E L NE NE

660 Ft. from N. Line Ft. from S. Line330 Ft. from E. Line Ft. from W. Line

STOLTENBERG POOL

SECTION PLAT

Location XRig up Drilling and Remarks:

RECORD

Cased in., ft.Sand Gas Oil Total Depth

PRODUCTION

1st 24 hrs. Nat. 1st 24 hrs. after shot Gas Cu. Ft.Dry Hole Abandoned

Date

FEB 21 1940 19S. J. LEWIS Scout

Map No. 53 Sec. 17 Twp. 16 R. 10WWell No. 2 HorejsiPhillips Petroleum Company

Contractor

COMPLETED**SECTION PLAT**

C E L N E N E

660 Ft. from N. Line Ft. from S. Line330 Ft. from E. Line Ft. from W. Line

			o

STOLTENBERG POOLLocation Rig up

Drilling and Remarks:

*22889**5" 22889**5000000**Pump 499 22889***RECORD**Cased in., ft.Sand Gas Oil Total Depth 3400**PRODUCTION**1st 24 hrs. Nat. 1st 24 hrs. after shot Gas Cu. Ft.Dry Hole Abandoned

Date

MAY 15 194019S. J. LEWIS Scout