

KANSAS

Form 51-5M-7-39-Palace


Ellsworth

Section 17 Township 16 Range 10-W

Well No. #1 Horejsi

Company Elwell et al

NORTH **Stoltenberg Pool**

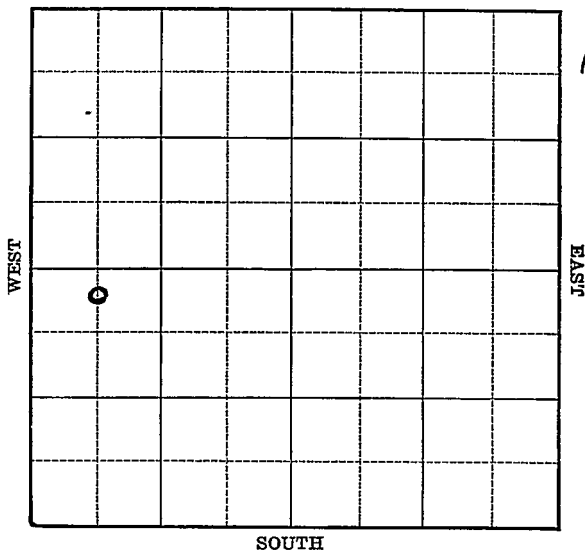

Sec. 17 Twp. 16 R. 10-W

Well No. #1 Horejsi Farm

Elwell et al Company

(Stoltenberg)


330 Ft. from N. Line

_____ Ft. from S. Line

_____ Ft. from E. Line

660 Ft. from W. Line

Elev. 1910

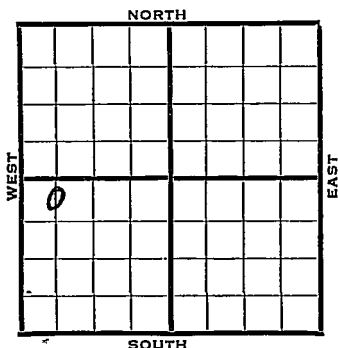

1940	REPORT
6/12	Derrick.
6/20	"
6/27	"
7/3	8" - 373' WOC.
7/11	Ft. Riley 1670' Drlg. 1945'
7/18	Lans. 3056' Drlg. 3275'
7/25	Arb. 3373' T.D. 3375'
	5" - 3374' RUST.
8/2	T.D. 3394' 500' oil. 1000 acid
	Pump 240 bbls. 12 hours.
8/7	Arb. 3373'
	5" - 3374'
	T.D. 3394'
	Potential 622 oil & 33 water on pump.

COMPLETED

Map No. 55 Sec. 17 Twp. 16 R. 10WWell No. 1 HorejsiElwell etal Company

Contractor

FIRST REPORT

C N L NW SW

330 Ft. from N. Line

_____ Ft. from S. Line

_____ Ft. from E. Line

660 Ft. from W. Line

STOLTENBERG POOL

SECTION PLAT

o			

Location _____

Rig up _____

Drilling and Remarks:

Derrick

RECORD

Cased _____ in., _____ ft.

Sand _____

Gas _____

Oil _____

Total Depth _____

PRODUCTION

1st 24 hrs. Nat. _____

1st 24 hrs. after shot _____

Gas _____ Cu. Ft.

Dry Hole _____

Abandoned _____

Date

JUN 12 1940

19

S. J. LEWIS Scout

Map No. 55 Sec. 17 Twp. 16 R. 10WWell No. 1 HorejsiElwell etal

Company

Contractor

COMPLETED

C N L NW SW

330 Ft. from N. Line

_____ Ft. from S. Line

_____ Ft. from E. Line

660 Ft. from W. Line

STOLTENBERG POOL

SECTION PLAT

o			

Location _____

Rig up _____

Drilling and Remarks:

*See 3373**5" @ 3374**Pump 622 oil
33 Water P.D.*

RECORD

Cased _____ in., _____ ft.

Sand _____

Gas _____

Oil _____

Total Depth 3394

PRODUCTION

1st 24 hrs. Nat. _____

1st 24 hrs. after shot _____

Gas _____ Cu. Ft.

Dry Hole _____

Abandoned _____

Date

AUG 7 1940 19S. J. LEWIS Scout