


Section 27 Township 25 Range 4E

Well No. 1 Perkins

Company Rex & Morris et al

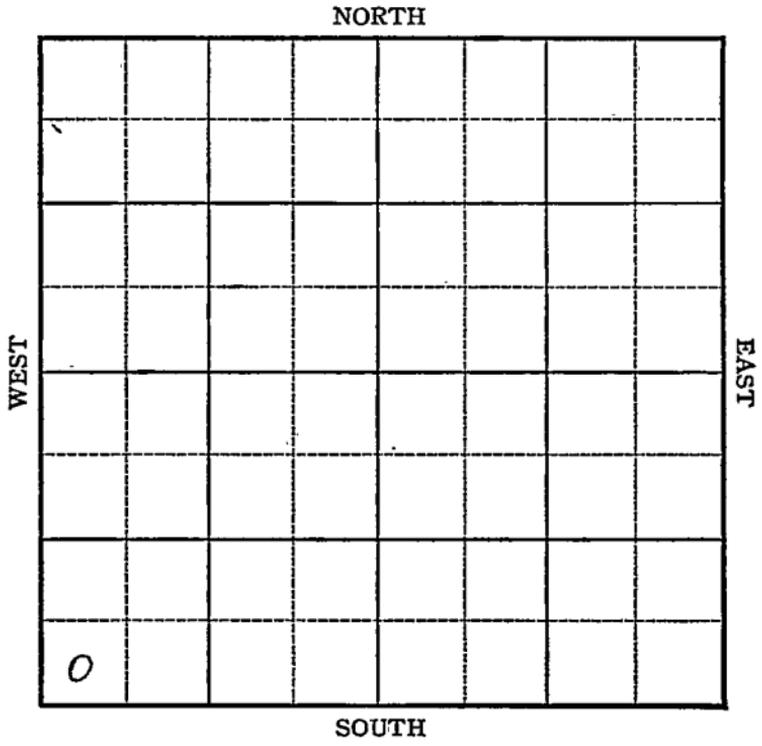

Sec. 27 Twp. 25 R. 4E

Well No. #1 Perkins Farm

Rex & Morris et al Company


Miscellaneous

_____ Ft. from N. Line

330 _____ Ft. from S. Line

_____ Ft. from E. Line

330 _____ Ft. from W. Line

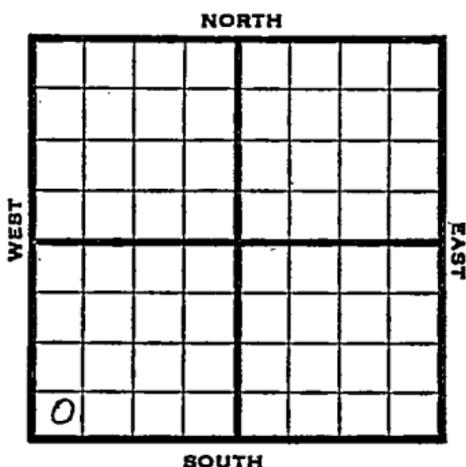

SW/c

1946 Elev 1337' REPORT

- 4/24 Location
- 5/1 Mach
- 5/7 15" @ 179
Drlg 325'
- 5/14 12" @ 830
Drlg 1350'
- 5/21 10" @ 1640'
Drlg 2200'
- 5/29 Miss 2592
6" @ 2592'
TD 2612'
Pump 100 Pot
38.0 Gr.

COMPLETED

Kansas Pool Name Miscellaneous

KANSAS

Map No. 74 Sec. 27 Twp. 25 R. 4E

Well No. 1 Perkins

Rex & Morris etal. Company

FIRST REPORT Contractor

SW/C


SECTION PLAT

_____ Ft. from N. Line

330 Ft. from S. Line

_____ Ft. from E. Line

330 Ft. from W. Line

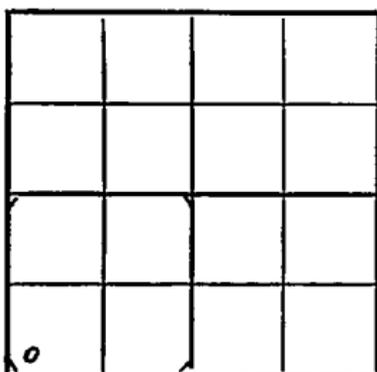

Butler County

Location X

Rig up _____

Drilling and Remarks:

RECORD

Cased _____ in., _____ ft.

Sand _____

Gas _____

Oil _____

Total Depth _____

PRODUCTION

1st 24 hrs. Nat. _____

1st 24 hrs. after shot _____

Gas _____ Cu. Ft.

Dry Hole _____

Abandoned _____

Date

APR 24 1946 19

S. J. LEWIS Scout

KANSAS Kansas Pool Name MiscellaneousMap No. 14 Sec. 27 Twp. 25 R. 4EWell No. 1 PerkinsRex & Morris etal. Company**COMPLETED**

Contractor

SW/C

E 11337
SECTION PLAT

0			

 Ft. from N. Line330 Ft. from S. Line Ft. from E. Line330 Ft. from W. LineButler CountyLocation Rig up

Drilling and Remarks:

Miss 25926" @ 2592Pump 100 ft38 3/4**RECORD**Cased in., ft.Sand Gas Oil Total Depth 2612'**PRODUCTION**1st 24 hrs. Nat. 1st 24 hrs. after shot Gas Cu. Ft.Dry Hole Abandoned

Date

MAY 29 1946 19S. J. LEWIS Scout