


Map No. Kans Sec. 32 Twp. 32 R. 6

Well No. 1 South Farm

Wakefield et al. Company

NORTH

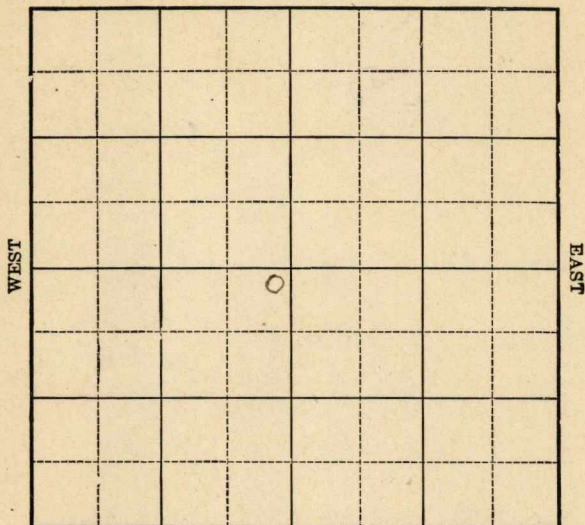

SOUTH

Location

Drilling Remarks

Rig Up_____

Drilling Remarks

RECORD

Cased _____ in. _____ ft.

Sand _____

Gas

Oil

Total Depth.....

PRODUCTION

1st 24 hrs. Nat.-----

1st. 24 hrs. after shot_____

Gas _____ cu. ft.

Dry Hole_____

Abandoned -----

Map No. 1 Kansas Sec. 32 Twp. 32 R. 6Well No. 1 Guthrie FarmWakefield et al Company200 Ft. from N. Line

Ft. from S. Line

200 Ft. from E. Line

Ft. from W. Line

NORTH

WEST

EAST

SOUTH

C.

Date
1925

REPORT

<u>3/24</u>	<u>Location</u>	
<u>5/29</u>	<u>Sand 1385-1430 H.F.W. 5' 10" 1450</u>	
<u>6/5</u>	<u>Sly 1670</u>	
<u>6/12</u>	<u>✓ 1700</u>	
<u>6/19</u>	<u>—————</u>	
<u>6/26</u>	<u>✓ 1917</u>	
<u>7/3</u>	<u>✓ 2025</u>	
<u>7/10</u>	<u>SD. 2310</u>	
<u>7/17</u>	<u>6" 2540</u>	
<u>7/24</u>	<u>2825'</u>	
<u>7/31</u>	<u>28 3097' Only 3108'</u>	
<u>8/7</u>	<u>3240'</u>	
<u>8/14</u>	<u>3395'</u>	
<u>8/20</u>	<u>Abandoned 3523</u>	

Map No. KANSAS Sec. 32 Twp. 32 R. 6

Well No. 1 Guthrie

Wakefield et al. Company

Contractor

FIRST REPORT

SECTION PLAT

200 Ft. from N. Line

_____ Ft. from S. Line

200 Ft. from E. Line

_____ Ft. from W. Line

	0		

Location ✓ ✓

Rig up _____

Drilling and Remarks:

RECORD

Cased _____ in., _____ ft.

Sand _____

Gas _____

Oil _____

Total Depth _____

PRODUCTION

1st 24 hrs. Nat. _____

1st 24 hrs. after shot _____

Gas _____ Cu. Ft.

Dry Hole _____

Abandoned _____

Date

3/24 1925

M. A. BENEAR

Scout

Cowley Co
 Map No. KANSAS Sec. 32 Twp. 32 R. 6
 Well No. 1 Ruthie

Wasefield Company
 Contractor

COMPLETED

SECTION PLAT

200 Ft. from N. Line

_____ Ft. from S. Line

200 Ft. from E. Line

_____ Ft. from W. Line

ABANDONED

Location _____

Rig up _____

Drilling and Remarks:

Top line 3097
Wilcox 3521-23
HFW,
dry 2 hrs

RECORD

Cased _____ in., _____ ft.

Sand _____

Gas _____

Oil _____

Total Depth 3523

PRODUCTION

1st 24 hrs. Nat. _____

1st 24 hrs. after shot _____

Gas _____ Cu. Ft.

Dry Hole ☒Abandoned ☒

Date

AUG 20 1925

192

CHAS. L. SHERWOOD

Scout