


Ellsworth **KANSAS**

SECTION 17 TOWNSHIP 16 RANGE 10W

WELL NO. #2 Horejsi

COMPANY Sterling Drlg.

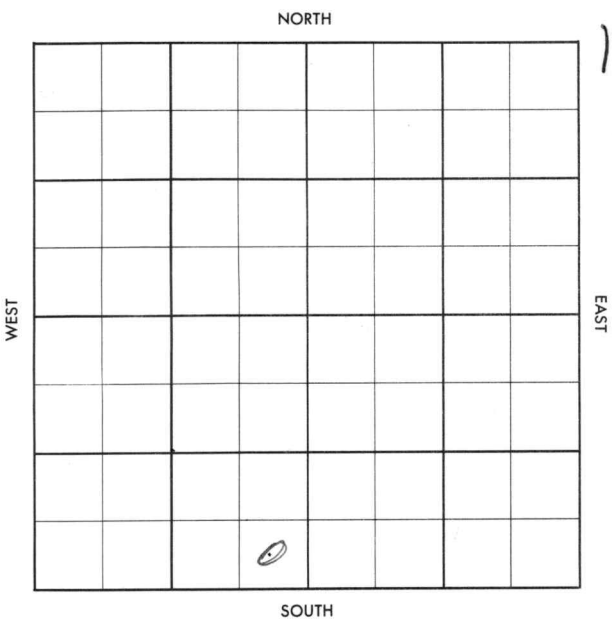

Ellsworth

Rice

KANSAS

SEC. <b>17</b>	TWP. <b>16</b>	R. <b>10W</b>
-------------------	-------------------	------------------

WELL NO. **#2 Horejsi** FARM

COMPANY **Sterling Drlg.**


CONTRACTOR **Co Tools  
Stoltenberg**

\_\_\_\_\_ FT. FROM N. LINE

\_\_\_\_\_ FT. FROM S. LINE

\_\_\_\_\_ FT. FROM E. LINE

\_\_\_\_\_ FT. FROM W. LINE

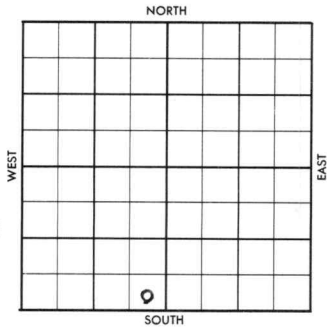

SE SE SW

<b>1956</b>	ELEVATION	REPORT
-------------	-----------	--------

**9-5**  
Comm 8-29-56  
8" @ 367 w/175  
Drlg 2965

2  
Ellsworth Co.

County Rice Elev. \_\_\_\_\_  
 Sec. 17 Twp. 16 Rge. 10W  
 Company Sterling Drlg.  
 Farm Name Horejsi No. 2

TOPS	DEPTH	LOG	DATUM
Anh.			
Tp.			
H.			
Tr.			
Dg.			
B.L.			
L.			
K.C.			
B.K.C.			
Ce.			
C.			
M.			
M.			
K.			
Mz.			
Ma.			
V.			
S.			
S.			
A.			
R.			
Pe.			
G.			
T.D.			

Loc. in Sec. SE SE SW  
 Geol. \_\_\_\_\_  
 Contr. \_\_\_\_\_  
 Co. Tools. \_\_\_\_\_  
 Pool \_\_\_\_\_  
Stoltenberg

SEP 5 1956  
 FIRST REPORT  
 0

Date Comm. 8/29/56  
8" @ 367 w/175, Drlg 2965

*[Handwritten signature]*

*[Faint handwritten notes]*

Co.  
Lse.  
No.  
Sec.  
T.  
R.



# CORRECTION

FORM 513 SUNRAY

County Ellsworth Elev. 1983 Co.  
 Sec. 17 Twp. 16 Rge. 10W  
 Company Sterling Drig.  
 Farm Name Horejsi No. 2

TOPS	DEPTH	LOG	DATUM	Loc. in Sec.
Anh.				SE SE SW
TP.				
H.	2919			
Tr.				
Dg.				
Bl.	3025			
L.	3048			
K.C.				Geol.
B.K.C.				Cont.
Ce.				Co. Tools.
C.				
M.				Pool
M.				Stoltenberg
K.				
Mz.				
Ma.				
V.				
S.				<div style="border: 1px dashed black; padding: 5px; font-weight: bold; font-size: 1.2em;">COMPLETE</div>
S.				
A.	3347			
R.				
PE.				OCT 3 '96
G.				
TD.	3355			

Date Comm. 8/29/56 No. Sec. T. R.  
3" @ 367 w/175, Drig 2965 SEP 12 '56  
DST 3348 - 55 90" rec 7' Md  
3HP 720/20" 5 1/2 @ 3355 SEP 19 '56  
DD 3365 \$ 15 GF 10' to wtr  
1hr 1/2 \$ 14.99 BFPK  
60% wtr 3 hrs Pol SEP 26 '56  
OCT 2" X P. 15 Bopd + 85% wtr  
Arch O.H. 3355 - 3365 TD  
complete