


KANSAS Ellsworth

FORM 51 IOM 12-46 PETROL

Section 17 Township 16 Range 10W

Well No. 2 Horejsi

Company B. W. Dawson

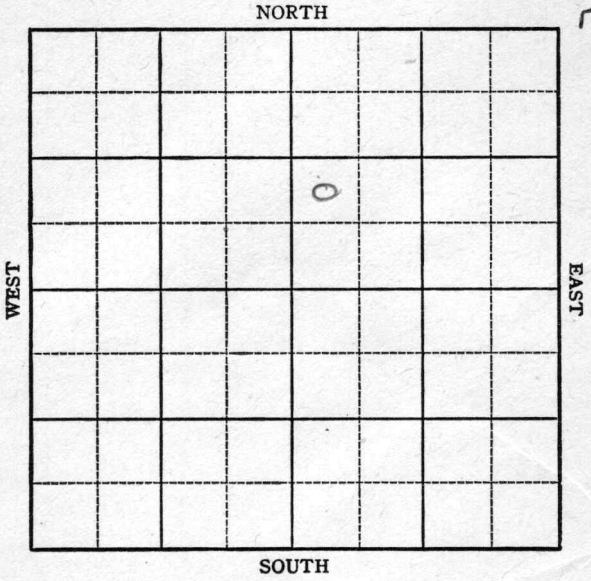

Sec. 17 Twp. 16 R. 10-W

Well No. #2 Horejsi Farm


B. W. Dawson Company
Bloomer Pool

 Ft. from N. Line

990 Ft. from S. Line

330 Ft. from E. Line

 Ft. from W. Line

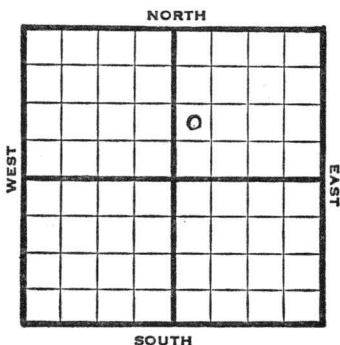

NW SW NE
NE SE NW

REPORT

1947 Elev. 1898'

5/21 10" @ 335'
Drlg 1492'

5/27 Lansing 3025'
Drlg. 3030'

6/3 " "

6/10 Lansing 3038
Arbuckle 3367-
5 " @ 3368'
TD 3382
SSO

6/17 TD 3383-500 acid swt
12 bbls oil in 10 hrs.

6/24 " " " " "

7/2 Arb. 3367'
5" @ 3368'
500 Acid
Pump 40 Pot
42.0 Gr.
TD 3383'

COMPLETED

Kansas

KANSAS

Map No. K 55 Sec. 17 Twp. 16 R. 10W

Well No. 2 Horejsi

B. W. Dawson

Company

FIRST REPORT

Contractor

NE SE NW

SECTION PLAT

	o		

 Ft. from N. Line

990 Ft. from S. Line

330 Ft. from E. Line

 Ft. from W. Line

Ellsworth County

Location _____

Rig up _____

Drilling and Remarks:

10" @ 335

drlg. 1492

RECORD

Cased _____ in., _____ ft.

Sand _____

Gas _____

Oil _____

Total Depth _____

PRODUCTION

1st 24 hrs. Nat. _____

1st 24 hrs. after shot _____

Gas _____ Cu. Ft.

Dry Hole _____

Abandoned _____

Date

MAY 21 1947 19

S. J. LEWIS

Scout

