



KANSAS

Ellsworth

Sec. 17 Twp. 16 R. 10W

Well No. #2 Horijsi "A" Farm

Bridgeport Company


Bloomer

         Ft. from N. Line

330 Ft. from S. Line

990 Ft. from E. Line

         Ft. from W. Line

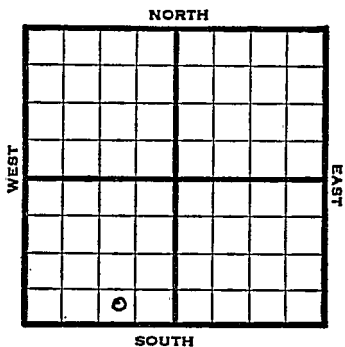

SW SE SW

1947	Elev. 1891' REPORT
10/1	Location Was Due & Farris
10/8	"
10/15	RUR
10/22	8" @ 895' Drlg. 2340'
10/29	Lansing 3056' Arbuckle 3350' TD 3350' 5" @ 3354' RUST
11/5	TD 3373'
11/12	Pump 15 bbls. oil in 18 hrs.
11/19	"
11/25	500 acid. Pump 23 bbls. oil SW in 5 hrs.
12/3	1000 Acid Pump 70 bbls fluid 33% W
12/10	Arbuckle 3350' 5" @ 3354' 1500 Acid Pump 45 oil & 65% W Pot Gr. 42° Total Depth 3373' <b>COMPLETED</b>

Map No. \_\_\_\_\_ Sec. 17 Twp. 16 R. 10W

Well No. 2 Horijsi "A"

Bridgeport \_\_\_\_\_ Company

**FIRST REPORT**

Contractor

SW SE SW

**SECTION PLAT**

\_\_\_\_\_ Ft. from N. Line

330 Ft. from S. Line

990 Ft. from E. Line

\_\_\_\_\_ Ft. from W. Line


Ellsworth County

Location \_\_\_\_\_ X

Rig up \_\_\_\_\_

Drilling and Remarks:

Was Due & Farris

**RECORD**

Cased \_\_\_\_\_ in., \_\_\_\_\_ ft.

Sand \_\_\_\_\_

Gas \_\_\_\_\_

Oil \_\_\_\_\_

Total Depth \_\_\_\_\_

**PRODUCTION**

1st 24 hrs. Nat. \_\_\_\_\_

1st 24 hrs. after shot \_\_\_\_\_

Gas \_\_\_\_\_ Cu. Ft.

Dry Hole \_\_\_\_\_

Abandoned \_\_\_\_\_

Date

OCT 1 1947

S. J. LEWIS

Scout

