

SECTION 17 TOWNSHIP 16 RANGE 10 W

WELL NO. #1 Horejsi "A"

COMPANY Gurrier et al

NORTH

|  |  |  |  |  |  |  |  |
|--|--|--|--|--|--|--|--|
|  |  |  |  |  |  |  |  |
|  |  |  |  |  |  |  |  |
WEST

EAST

SOUTH

13

0

## KANSAS

SEC.

TWP.

R.

17

16

104

WELL NO.

## #1 Horejsi "A"

FARM

**COMPANY**

Currier et al

**CONTRACTOR**

# Sterling

NORTH


Ft. from N. Line

Ft. from S. Line

Ft. from E. Line

Ft. from W. Line

NE SW SW

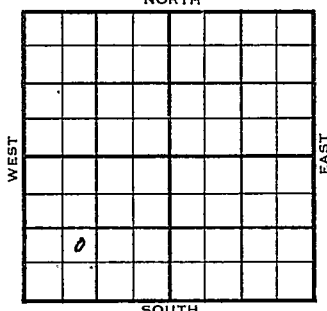

1955

ELEVATION

1894

## REPORT

11/2

Comm 10-31-55

811' @ 340/160

**WOC**

12-21

DST 3376-80 op 1 hr. rec. 60' gas, 17'  
ocm, 15' mud, 870/30"

57" @ 3376/50

CO to 3380'

B/ 17 goph 2 hrs.

FU 240' oil 12 hrs., 1000 A

S/ 2.09 bo 1 hr., 2000 A.

S/ 7.9 bo 1 hr.

S/ 5 bo 1 hr.

FU 940' oil, 440' wtr., 15 hrs.

Comp. 30 bopd, 50% wtr.

H. 2934

BL. 3035

L. 3055

C. 3359

A. 3374

TD 3380

**COMPLETED**

County Ellsworth Elev. \_\_\_\_\_  
 Sec. 17 Twp. 16 Rge. LOW  
 Company Currier et al.  
 Farm Name Horejsi "A" No. 1

| TOPS   | DEPTH | LOG | DATUM | Loc. in Sec.    |
|--------|-------|-----|-------|-----------------|
| Anh.   |       |     |       | NE SW SW        |
| Tr.    |       |     |       |                 |
| Dg.    |       |     |       |                 |
| Bl.    |       |     |       |                 |
| L.     |       |     |       | Geol.           |
| K.C.   |       |     |       | Contr.          |
| B.K.C. |       |     |       | <u>Sterling</u> |
| Ce.    |       |     |       | Pool            |
| C.     |       |     |       |                 |
| M.     |       |     |       |                 |
| M.     |       |     |       |                 |
| K.     |       |     |       |                 |
| Mz.    |       |     |       |                 |
| Mo.    |       |     |       |                 |
| V.     |       |     |       |                 |
| S.     |       |     |       |                 |
| S.     |       |     |       |                 |
| A.     |       |     |       |                 |
| R.     |       |     |       |                 |
| Pe.    |       |     |       |                 |
| G.     |       |     |       |                 |
| T.D.   |       |     |       |                 |

Date Comm. 10-31-55  
8" @ 340/160 WOC

12

County Ellsworth Elev. 1894  
 Sec. 17 Twp. 16 Rge. 10W  
 Company Currier et al.  
 Farm Name Horejsi "A" No. 1

| TOPS   | DEPTH       | LOG | DATUM       | Loc. in Sec. |
|--------|-------------|-----|-------------|--------------|
| Anh.   |             |     |             | NE SW SW     |
| Tp.    |             |     |             |              |
| H.     | <u>2934</u> |     | <u>1040</u> |              |
| Tr.    |             |     |             |              |
| Dg.    |             |     |             |              |
| Bl.    | <u>3035</u> |     | <u>1141</u> | Geol.        |
| L.     | <u>3053</u> |     | <u>1161</u> |              |
| K.C.   |             |     |             | Contr.       |
| B.K.C. |             |     |             |              |
| Ce.    |             |     |             | Sterling     |
| C.     | <u>3359</u> |     | <u>1465</u> |              |
| M.     |             |     |             | Pool         |
| M.     |             |     |             |              |
| K.     |             |     |             |              |
| Mz.    |             |     |             |              |
| Mo.    |             |     |             |              |
| V.     |             |     |             |              |
| S.     |             |     |             |              |
| S.     |             |     |             |              |
| A.     | <u>3374</u> |     | <u>1480</u> | COMPLETE     |
| R.     |             |     |             |              |
| PE.    |             |     |             |              |
| G.     |             |     |             |              |
| T.D.   | <u>3380</u> |     |             |              |

Date Comm. 10-31-55 DEC 2 1 1955

8" @ 340/160 DST 3376-80 open 1 hr.

rec. 60' gas 17' ocm 15' mud 870/30"

5 $\frac{1}{2}$ " @ 3376/50 CO to 3380 B/ 17 goph

2 hr. FU 240' oil 12 hr. 1000 A

S/ 2.09 bo 1 hr. 2000 A S/ 7.9 bo

1 hr. S/ 5 bo 1 hr. FU 940' oil

1440' wtr. 15 hr. Comp. 30 bopd 50% wtr.