


Section 17 Township 16 Range 10-W

Well No. #2 Horejsi Estate

Company Magnolia

Stoltenberg pool NORTH

3

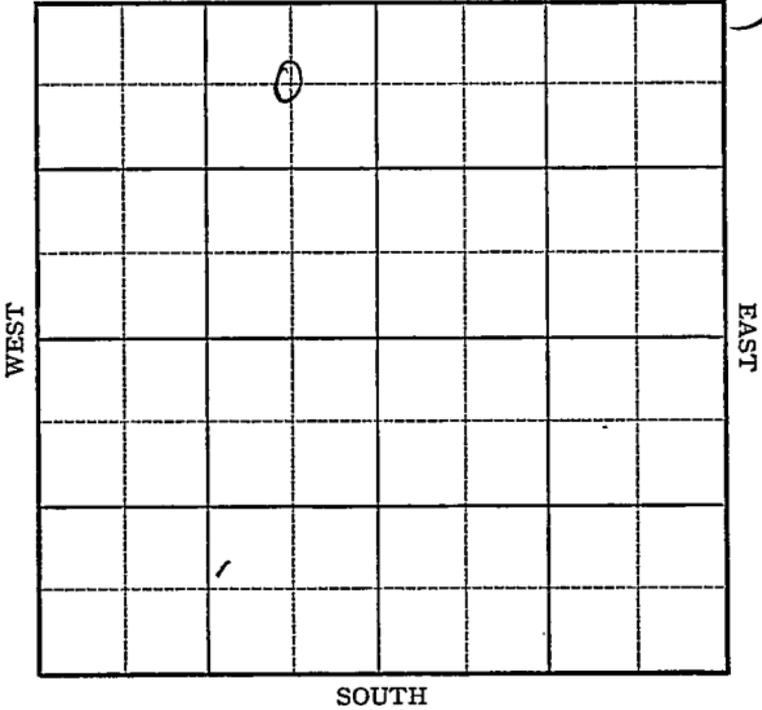

**KANSAS**

Ellsworth

Sec. 17 Twp. 16 R. LOW

Well No. #2 Horejsi Estate Farm

Magnolia Company

Stoltenberg pool


660 Ft. from N. Line

         Ft. from S. Line

660 Ft. from E. Line

         Ft. from W. Line

C NE NW Elev. 1893

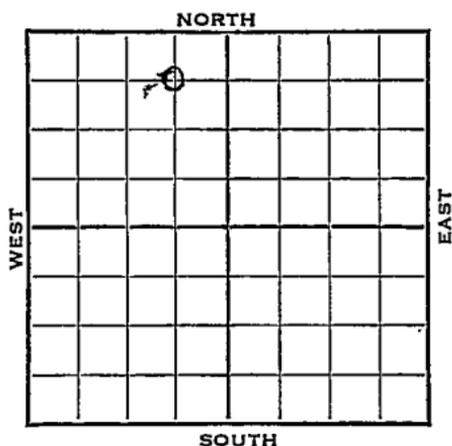

1942 REPORT

11/10	Location
11/18	Drlg 165'
11/24	10" @ 374 Drlg. 1985'
12/2	Arb 3357 TD 3360 Run 5"
12/9	5" @ 3358 TD 3374-1000 acid
12/16	Arb. 3357 5" @ 3358' T.D. 3374' Pump 47 bbls. oil pot. 3000 gals. acid. Gravity 43

**COMPLETED**

**KANSAS**Map No.            Sec. 17 Twp. 16 R. 10WWell No. 2 Horejsi EstateMagnolia

Company

**FIRST REPORT**

Contractor

C NE NW

## SECTION PLAT

660 Ft. from N. Line           Ft. from S. Line660 Ft. from E. Line           Ft. from W. Line

	o		

**STOLTENBERG POOL**Location XXXRig up           

Drilling and Remarks:

## RECORD

Cased            in.,            ft.Sand           Gas           Oil           Total Depth           

## PRODUCTION

1st 24 hrs. Nat.           1st 24 hrs. after shot           Gas            Cu. Ft.Dry Hole           Abandoned           

Date

NOV 11 1942

19

S. J. LEWIS

Scout

~~KANSAS~~

Ellsworth

Map No. 55 Sec. 17 Twp. 16 R. LOWWell No. 2 Horejsi EstateMagnolia

Company

**COMPLETED**

Contractor

C NE NW

## SECTION PLAT

660 Ft. from N. Line         Ft. from S. Line660 Ft. from E. Line         Ft. from W. Line

	o		

## STOLTENBERG POOL

Location                                 Rig up                                 

Drilling and Remarks:

*Cel 43357**5" @ 3358.**2000 acid**Pump 47 P.Y.**43° Gr*

## RECORD

Cased                  in.,                  ft.Sand                                 Gas                                 Oil                                 Total Depth 3374

## PRODUCTION

1st 24 hrs. Nat.                                 1st 24 hrs. after shot                                 Gas                                  Cu. Ft.Dry Hole                                 Abandoned                                 

Date

DEC 16 1942

19

S. I. LEWIS Scout