

KANSAS

Ellsworth


Form 51-5M-7-40-Palace

Section 17 Township 16 Range 10-W

Well No. #1 Hynek

Company Duwe & Farris et al

NORTH Stoltenberg Pool

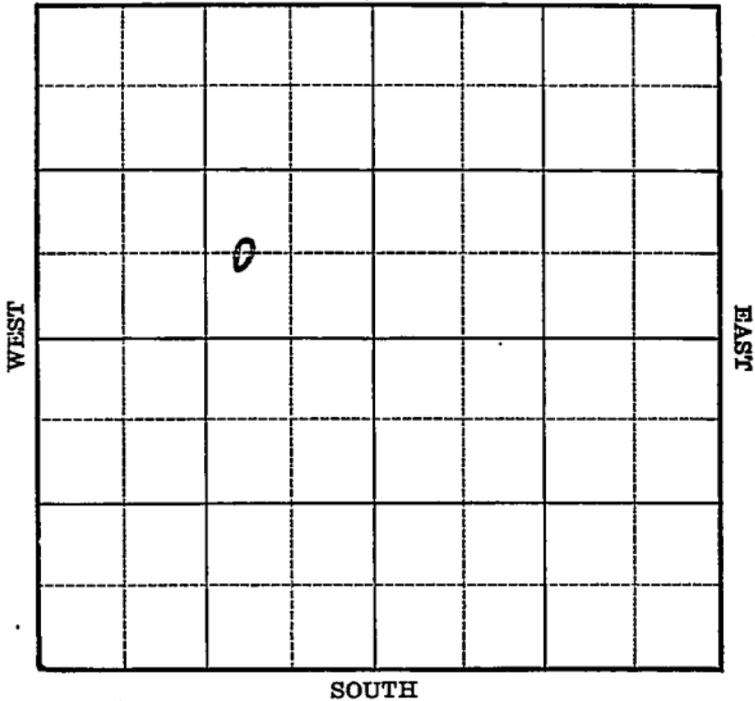

Map No. 55 Sec. 17 Twp. 16 R. 10W

Well No. 1 Hynek

Duwe & Farris et al Company

Contractor

FIRST REPORT

C W L S E N W

_____ Ft. from N. Line

660 Ft. from S. Line

990 Ft. from E. Line

_____ Ft. from W. Line

SECTION PLAT

STOLTENBERG POOL

Location _____

Rig up _____

Drilling and Remarks:

Derrick

RECORD

Cased _____ in., _____ ft.

Sand _____

Gas _____

Oil _____

Total Depth _____

PRODUCTION

1st 24 hrs. Nat. _____

1st 24 hrs. after shot _____

Gas _____ Cu. Ft.

Dry Hole _____

Abandoned _____

Date

MAY 14 1941

19

S. J. LEWIS Scout

Map No. _____ Sec. 17 Twp. 16 R. 10WWell No. 1 Hynek_____ Duwe & Farris etal _____ Company_____ **ABANDONED** _____ Contractor**SECTION PLAT**

C W L SE NW

_____ Ft. from N. Line

660 Ft. from S. Line990 Ft. from E. Line

_____ Ft. from W. Line

STOLTENBERG POOL

	o		

Location _____

Rig up _____

Drilling and Remarks:

Cut 3382
Water

RECORD

Cased _____ in., _____ ft.

Sand _____

Gas _____

Oil _____

Total Depth 3382**PRODUCTION**

1st 24 hrs. Nat. _____

1st 24 hrs. after shot _____

Gas _____ Cu. Ft.

Dry Hole _____

Abandoned _____

Date

JUN 4 1941S. J. LEWIS Scout