


FOR **KANSAS** BY **PETROL**

Section 18 Township 16 Range 10W

Well No. #1 Buekler

Company Ingling & Alpine

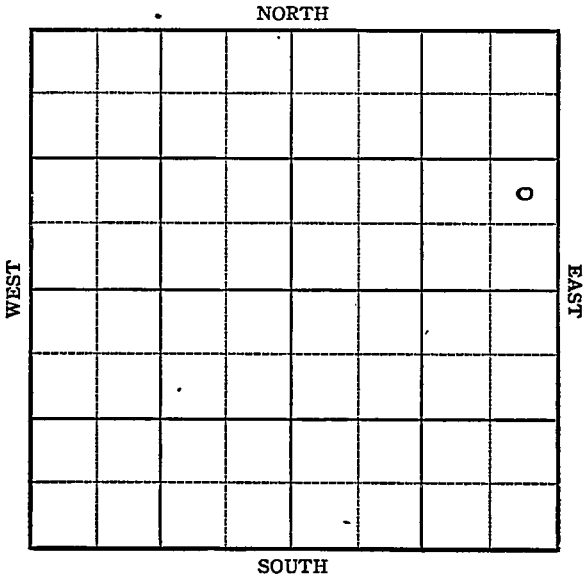

Sec. 18 Twp. 16 R. 10-W

Well No. #1 Buckler Farm

Ingling & Alpine Company


_____ Ft. from N. Line

990 Ft. from S. Line

330 Ft. from E. Line

_____ Ft. from W. Line

elev. 1913

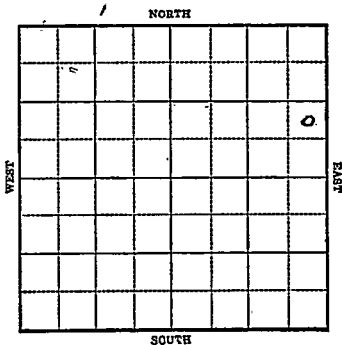

1944

R E P O R T

2/2 8" @ 386
Drlg. 1670'

2/9 Drlg. 2675

2/15 Lans 3062
Arb 3381-88 TD
5" @ 3381
Rust

2/23 "

3/1 5" @ 3381
Arb 3381
TD 3388
1500 acid
Pump 100 Pot.
Gravity 41.7

COMPLETED

KANSAS

Map No. 55 Sec. 18 Twp. 16 R. 10WWell No. 1 BuehlerIngling & Alpine CompanyCOMPLETED Contractor

NE SE NE

SECTION PLAT

| | | | |
|--|--|--|--|
| | | | |
| | | | |
| | | | |
| | | | |

_____ Ft. from N. Line

990

_____ Ft. from S. Line

330

_____ Ft. from E. Line

_____ Ft. from W. Line

Stoltenberg Pool

Location _____

Rig up _____

Drilling and Remarks:

*2283381**5' 10" 3381**1500 acid**Pump 100 Pst**4/2/44*

RECORD

Cased _____ in., _____ ft.

Sand _____

Gas _____

Oil _____

Total Depth 2381

PRODUCTION ;

1st 24 hrs. Nat. _____

1st 24 hrs. after shot _____

Gas _____ Cu. Ft.

Dry Hole _____

Abandoned _____

Date

MAR 1 1944 19

S. J. LEWIS Scout