


KANSAS Ellsworth

FORM 51 5M PETROL

Section 18 Township 16 Range 10W

Well No. 2 Buehler

Company Lion Oil

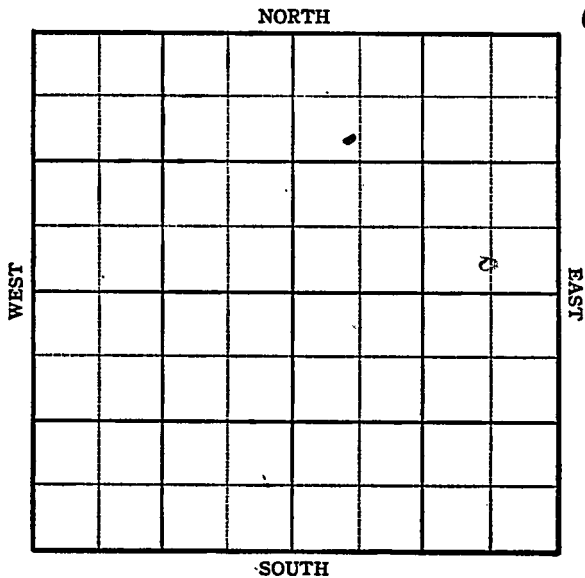

KANSAS

Ellsworth County

Sec. 18 Twp. 16 R. 10W

Well No. #2 Buehler Farm

Lion Oil Company

Stolzenberg


_____ Ft. from N. Line

330 Ft. from S. Line

660 Ft. from E. Line

_____ Ft. from W. Line

CSL SE NE

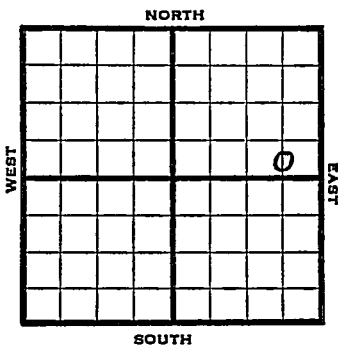

1945

REPORT

Elev. 190 $\frac{1}{2}$

10/31 Was Ingling lease
Location

11/7 8" @ 347 WOC

11/14 Drlg. 2305'

11/21 Drlg. 3180'

11/28 Lans. 3061

Arb. 3404

TD 3420'

ABANDONED

KANSAS Kansas Pool Name StoltenbergMap No. 52 Sec. 18 Twp. 16 R. 10WWell No. 2 BuehlerLion Oil

Company

FIRST REPORT

Contractor

C S L SE NE

SECTION PLAT

 Ft. from N. Line330 Ft. from S. Line660 Ft. from E. Line Ft. from W. Line

| | | | |
|--|--|--|--|
| | | | |
| | | | |
| | | | |
| | | | |

Ellsworth County

Location XRig up

Drilling and Remarks:

was Ingling lease

RECORD

Cased in., ft.Sand Gas Oil Total Depth

PRODUCTION

1st 24 hrs. Nat. 1st 24 hrs. after shot Gas Cu. Ft.Dry Hole Abandoned

Date

OCT 3 1 1945 19

S. J. LEWIS

Scout

Pool Name Stoltenberg

KANSAS Kansas

Map No. 55 Sec. 18 Twp. 16 R. 10W

Well No. 2 Buehler

Lion Oil Company

ABANDONED

Contractor

C S L SE NE

E. 1901
SECTION PLAT

 Ft. from N. Line

330 Ft. from S. Line

660 Ft. from E. Line

 Ft. from W. Line

| | | | |
|--|--|--|---|
| | | | |
| | | | |
| | | | 2 |
| | | | |
| | | | |

Ellsworth County

Location

Rig up

Drilling and Remarks:

lane 3061

Cr 3404

RECORD

Cased in., ft.

Sand

Gas

Oil

Total Depth 3420

PRODUCTION

1st 24 hrs. Nat.

1st 24 hrs. after shot

Gas Cu. Ft.

Dry Hole

Abandoned

Date

NOV 28 1945 19

S. J. LEWIS Scout