


KANSAS

Map No. \_\_\_\_\_ Sec. 28 Twp. 25 R. 4

Well No. 2 - Pierce Farm \_\_\_\_\_

Allison + Fitzwilliams Company

NORTH

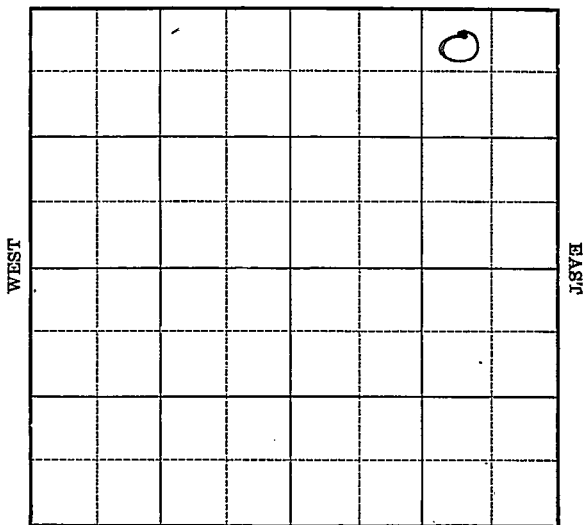

SOUTH

Location \_\_\_\_\_

Drilling Remarks \_\_\_\_\_

\_\_\_\_\_

\_\_\_\_\_

**RECORD**

Cased \_\_\_\_\_ in. \_\_\_\_\_ ft.

Sand \_\_\_\_\_

Gas \_\_\_\_\_

Oil \_\_\_\_\_

Total Depth \_\_\_\_\_

Rig Up \_\_\_\_\_

Drilling Remarks \_\_\_\_\_

\_\_\_\_\_

\_\_\_\_\_

**PRODUCTION**

1st 24 hrs. Nat. \_\_\_\_\_

1st 24 hrs. after shot \_\_\_\_\_

Gas \_\_\_\_\_ cu. ft.

Dry Hole \_\_\_\_\_

Abandoned \_\_\_\_\_



Butler

14 KANSAS Map No. Sec. 28 Twp. 25 R. 4<sup>E</sup>

Well No. 2 Pierce

Allison & Fitzwilliams Company

Contractor

FIRST REPORTS

330 Ft. from N. Line

\_\_\_\_\_ Ft. from S. Line

990 Ft. from E. Line

\_\_\_\_\_ Ft. from W. Line

SECTION PLAT

			o

Location \_\_\_\_\_

Rig up \_\_\_\_\_

Drilling and Remarks:

RECORD

Cased \_\_\_\_\_ in., \_\_\_\_\_ ft.

Sand \_\_\_\_\_

Gas \_\_\_\_\_

Oil \_\_\_\_\_

Total Depth \_\_\_\_\_

PRODUCTION

1st 24 hrs. Nat. \_\_\_\_\_

1st 24 hrs. after shot. \_\_\_\_\_

Gas \_\_\_\_\_ Cu. Ft.

Dry Hole \_\_\_\_\_

Abandoned \_\_\_\_\_

Date APR 26 1928

CHAS. L. SHERWOOD

192 Scout

*Butter*

MAP NO. 14 KANSAS SEC. 28 TWP. 25 R. 4

WELL NO. 2 fierce

Allison & Fitzwilliams COMPANY

CONTRACTOR

**COMPLETED**

**SECTION PLAT**

			0

330 FT. FROM N. LINE

FT. FROM S. LINE

990 FT. FROM E. LINE

FT. FROM W. LINE

LOCATION \_\_\_\_\_

RIG UP \_\_\_\_\_

DRILLING AND REMARKS:

*90 Bls: Natural*

**RECORD**

CASED \_\_\_\_\_ IN. \_\_\_\_\_ FT.

SAND 7554-7605

GAS \_\_\_\_\_

OIL \_\_\_\_\_

TOTAL DEPTH 7605

**PRODUCTION**

1ST 24 HRS. NAT. \_\_\_\_\_

1ST 24 HRS. AFTER SHOT \_\_\_\_\_

GAS \_\_\_\_\_ CU. FT.

DRY HOLE \_\_\_\_\_

ABANDONED \_\_\_\_\_

DATE

JUN 20 1928

**CHAS. L. SHERWOOD**

SCOUT