


Section 2 Township 32 Range 7E

Well No. 1 D. Barger

Company Texas Co.

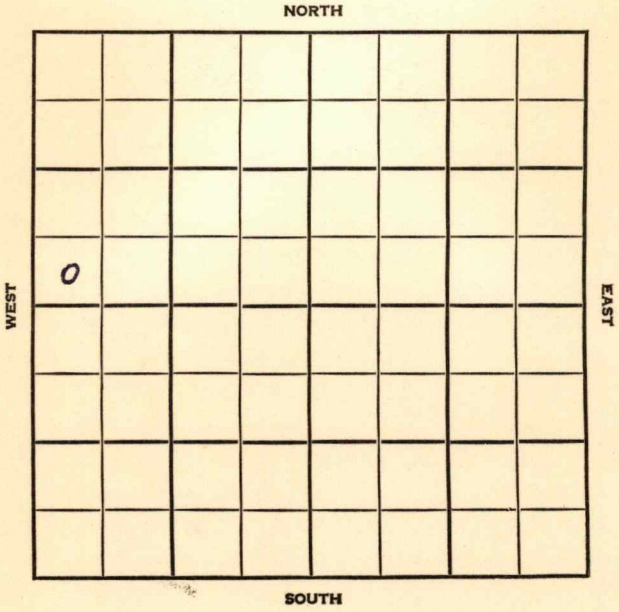

Cowley

KANSAS

SEC.	TWP.	R.
2	32	7E

WELL NO. \_\_\_\_\_

#1 D. Barger \_\_\_\_\_ FARM

COMPANY \_\_\_\_\_

CONTRACTOR \_\_\_\_\_

Texas Company \_\_\_\_\_

Capitt \_\_\_\_\_


N. School Creek Pool

\_\_\_\_\_ Ft. from N. Line

330 \_\_\_\_\_ Ft. from S. Line

\_\_\_\_\_ Ft. from E. Line

330 \_\_\_\_\_ Ft. from W. Line

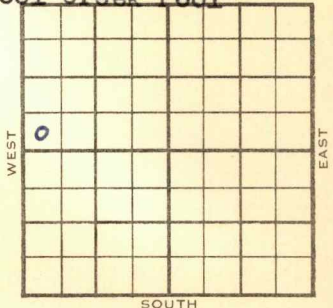

SW SW NW

1955	ELEVATION	REPORT
------	-----------	--------

4/20

Location

11-10

TD 2159  
 7" @ 2146/100  
 CO to 2159  
 Test 25 go, 348 gw 6 hrs.

County **Cowley** State **Kansas**

Sec. **2** (Blk. Twp.) **32** (Sur. Rge.) **7E** Map No.

Operator **Texas Company**

Well No. **1** Farm **D. Barger**

Elev. Location **SW SW NW**


**330** Ft. From **S** Line **NW**

**330** Ft. From **W** Line Quarter

1st. Report **APR 20 1955**

Completion

Remarks

**Capitt - Contr.**

Spudding Date

Drlg. Data **N. School Creek Pool**

**Location**