


Cowley

KANSAS

SECTION 2 TOWNSHIP 32 RANGE 7 E

WELL NO. #2 D. O. Barger

COMPANY Texas Co.

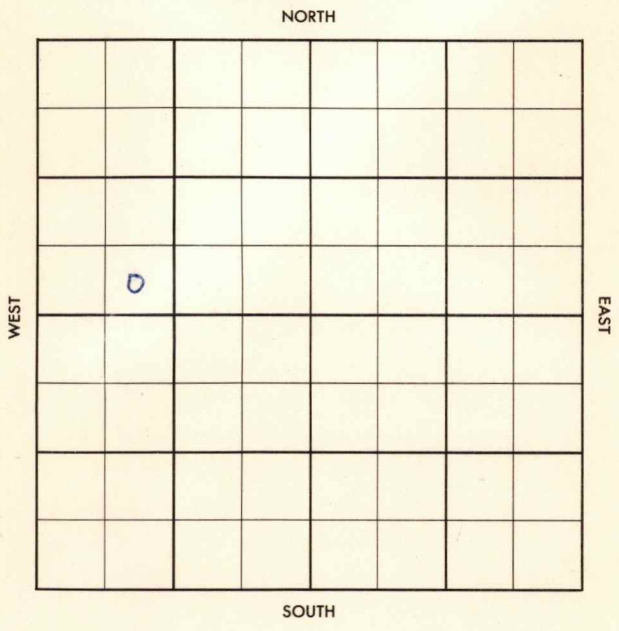

Cowley

KANSAS


SEC.	TWP.	R.
2	32	7 E

WELL NO. # 2 D. O. Barger FARM

COMPANY Texas Company

CONTRACTOR Capitt  
N. School Creek

\_\_\_\_\_ Ft. from N. Line  
 \_\_\_\_\_ Ft. from S. Line  
 \_\_\_\_\_ Ft. from E. Line  
 \_\_\_\_\_ Ft. from W. Line

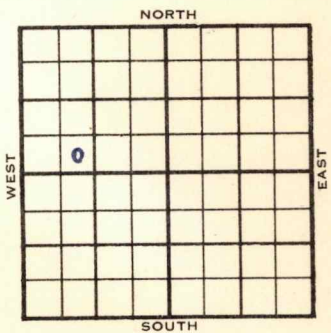

SE SW NW

SDX - 1 Mile

	ELEVATION	REPORT
1955	1408'	

11/2 Comm. 10-25-55  
 10" @ 123/125  
 DST 2151-56 open 1 hr rec 6' drlg. mud  
 Drlg. 2159'

11-16 7" @ 2146/100  
 CO to 2159  
 25 go, 348 gw 6 hr.  
 300 A, 84 bw, 5 hrs., frac  
 D & A


<u>Tops:</u>	<u>Log</u>
Dg. sd	1563
Tp.	2020
Skinner sd	1734
Lower	1855
Group	2087
Layton A	2095
" B	2131
" C	2153

TD 2159'

ABANDONED

County **Cowley** Elev. \_\_\_\_\_  
 Sec. **2** Twp. **32** Rge. **7E**  
 Company **Texas Company**  
 Farm Name **D. O. Barger** No. **2**

TOPS	DEPTH	LOG	DATUM	Loc. in Sec.
Anh.				SE SW NW
Tp.				
H.				
Tr.				
Dg.				
Bl.				
L.				Geol. _____
K.C.				Contr. _____
B.K.C.				
Ce.				<b>Capitt</b>
C.				
M.				Pool _____
M.				
K.				<b>N. School Cree</b>
Mz.				
Ma.				
V.				
S.				
S.				
A.				
R.				
Pe.				
G.				
T.D.				

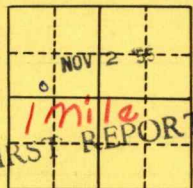

Date Comm. **10-25-55**  
**10" @ 123/125 DST 2151-56 open 1 hr.**  
**rec. 6' drlg. mud drlg. 2159**

Co.  
Lse.  
No.  
Sec.  
T.  
R.

County Cowley Elev. 1408  
 Sec. 2 Twp. 32 Rge. 7E  
 Company Texas Company  
 Farm Name D. O. Barger No. 2

TOPS	DEPTH	LOG	DATUM
Anh.			
TP.		1020	
H.			
Tr.			
Dg.		1563	155
Bl. <i>Skinner</i>		1734	326
L. <i>Zimmer</i>		1855	447
K.C. <i>Group</i>		2087	679
B.K.C. <i>Hayton A</i>		2095	687
Ce. <i>" B</i>		2131	723
C. <i>" C</i>		2153	745
M.			
M.			
K.			
Mz.			
Ma.			
V.			
S.			
S.			
A.			
R.			
PE.			
G.			
TD.	2159		

Loc. in Sec. SE SW NW  
 Geol. \_\_\_\_\_  
 Contr. \_\_\_\_\_  
 Pool \_\_\_\_\_  
Capitt  
N. School Cree



Date Comm. 10-25-55 NOV 16 1955  
10" @ 123/125 DST 2151-56 open 1 hr.  
rec. 6' drlg. mud 7" @ 2146/100  
CO to 2159 25 go 348 gw 6 hr.  
300 A 84 bw 5 hr. frac  
D & A

Co.  
 Lse.  
 No.  
 Sec.  
 T.  
 R.