


Section 2 Township 32 Range 7 E

Well No. # 3 Rogers

Company Texas Company

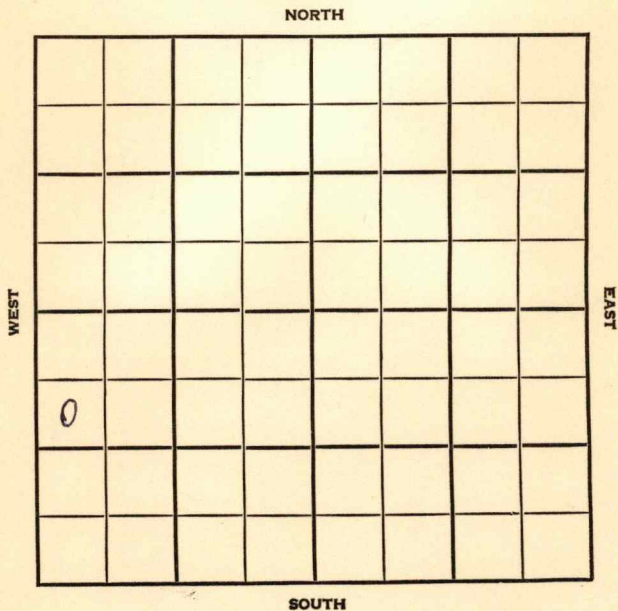

Cowley KANSAS

SEC.	TWP.	R.
2	32	7E

WELL NO. FARM
 3 Rogers

COMPANY
 Texas Co.

CONTRACTOR
 Capitt


990 _____ Ft. from N. Line

_____ Ft. from S. Line

_____ Ft. from E. Line

330 _____ Ft. from W. Line

School Creek Pool

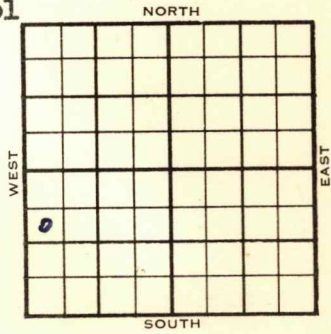

SW NW SW

1954	ELEVATION 1419'	REPORT
------	---------------------------	--------

11/10 Spud 11-8-54
 Drlg. 167'

11/23 Spud 11-8-54
 Oil Well
 TD 2240'
Stal. 1717', Lans 1853' KC 2081'
Layton 2089' KC Lm 2211'
 TD 2240'
 7" @ 2239'
 CO to 2170'
 21/ 2148-56 S/ 5 bo 5 bw. 5½ hr.
 sd-frac. P/ 645 bo 36 bw. 24 hr.
 Comp 25 bopd.

COMPLETED

County **Cowley** State **Kansas**
 Sec. **2** (Blk.) **32** (Sur.) **7E** Map No.
 Operator **Texas Company**
 Well No. **3** Farm **Rogers**
 Elev. Location **SW NW SW**

FIRST REPORT

990 Ft. From **N** Line **SW**
330 Ft. From **W** Line **Quarter**
 Ist. Report **NOV 10 1954**
 Completion _____
 Remarks **Capitt - Contr.**
 Spudding Date **11-8-54**
School Creek Pool

Drlg. Data
drlg. 167

FABEN GILSTRAP

