


Section 2 Township 32 Range 7 EWell No. # 2 C. W. RogersCompany Texas Company

NORTH

WEST

EAST

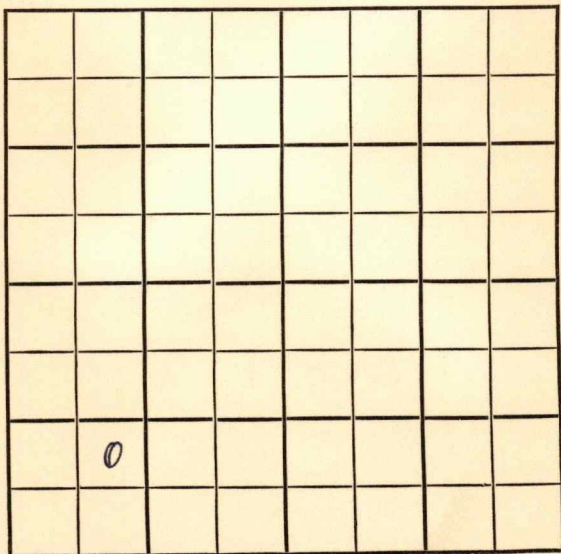

SOUTH

Cowley KANSAS

SEC.	TWP.	R.
2	32	7E
WELL NO.		
#2 C.W. Rogers		FARM
COMPANY		
Texas Company		
CONTRACTOR		

Capitt


School Creek Pool

_____ Ft. from N. Line

990 _____ Ft. from S. Line

_____ Ft. from E. Line

990 _____ Ft. from W. Line

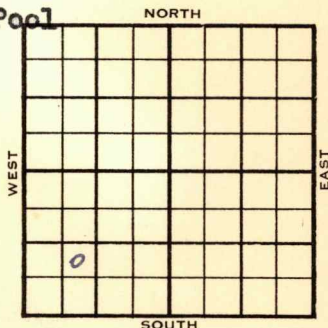

NE SW SW

	ELEVATION	REPORT
1954	1413	
11/10	Spud 10-29-54 10-3/4" @ 146' Drlg. 1485'	
12/8	Spud 10-29-54 Oil well TD 2239 10-3/4" 10-3/4" @ 146 Top. 1020 Doug. 1558 Stal. 1729 Br. lime 1857 KC 2082 Layton 2090 TD 2239 5" @ 2239 CO to 2214 31/2174-84 S/6 BO 61 GW 7 hr. 500 A Sd-frac. S & F/58 BO 47 BW 5 hr. PB 2167 31/2150-60 S/53 BO 264 BW 9 hr. DOC - treatment CO S/14 GO 1 hr. 500 A sd-frac. S/35 BO 53 BW 8 hr. S/101 BO 160 BW 24 hrs. CO 19/2148-54 19 GO 170 GW 3 hr. sd-frac. F/7 BO S/22 BO 65 BW 7 hr. Comp. 42 BOPD 91 BW	
	COMPLETED	

County **Cowley** State **Kansas**
 Sec. **2** (Blk. **32** (Sur. **7E** Map No.
 (Twp.) (Rge.)
 Operator **Texas Company**
 Well No. **2** Farm **C. W. Rogers**
 Elev. **1413** Location **NE SW SW**



990 Ft. From **S** Line **SW**
 990 Ft. From **W** Line **Quarter**
 1st. Report
 Completion **DEC 8 1954**
 Remarks **School Creek Pool**
Capitt - Contr.
 Spudding Date **10-29-54**

Drlg. Data **Oil well** **TD 2239**
10 3/4" @ 146 **Top. 1020** **Doug. 1558**
Stal. 1729 **Br. lime 1857** **KC 2082**
Layton 2090 **TD 2239** **5" @ 2239**
C0 to 2214 **31/ 2174-84** **S/ 6 bo 61 gw**
7 hr. 500 A **sd-frac** **S & F/ 58 bo**
47 bw 5 hr. PB 2167 **31/ 2150-60**
S/ 53 bo 264 bw 9 hr. DOC-treatment
C0 S/ 14 go 1 hr. 500 A **sd-frac**
S/ 35 bo 53 bw 8 hr. S/ 101 bo
160 bw 24 hr. C0 **19/ 2148-54**
19 go 170 gw 3 hr. sd-frac
F/ 7 bo S/ 22 bo 65 bw 7 hr.
Comp. 42 bopd 91 bw

FABEN GILSTRAP