

Cowley

KANSAS

SEC. 3	TWP. 32S	R. 7E
-----------	-------------	----------

WELL NO. 3 D. S. Ankraom FARM

COMPANY The Texas Co.

CONTRACTOR


School Creek No. Pool

_____ Ft. from N. Line

_____ Ft. from S. Line

_____ Ft. from E. Line

_____ Ft. from W. Line

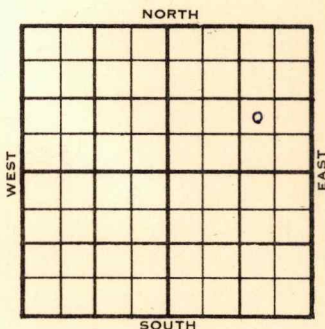

NW SE NE

1955	ELEVATION 1398'	REPORT
------	--------------------	--------

5/25

Haskell 1660; Stal 1746; Lsg 1848;
 K. C. 2078; Lay #1 2085; Lay #2 2121;
 Lay #3 2144;
 TD 2224, 10" 128; 7" 2223; RTD 2224;
 CO 2192; 12/2148-52; test 9 bw trc
 oil; frac; CO 2157; 31/2146-56
 swb 11 bwph 2 hrs, no show oil or gas
 frac; D&A

FIRST REPORT

x

ABANDONED