



*Butler*

Map No. **KANSAS** Sec. *28* Twp. *25* R. *4<sup>E</sup>*

Well No. *H - Pierce* Farm  
*Allison - Fitzwilliams* Company


NORTH

*330* Ft. from N. Line

\_\_\_\_\_ Ft. from S. Line

*330* Ft. from E. Line

\_\_\_\_\_ Ft. from W. Line

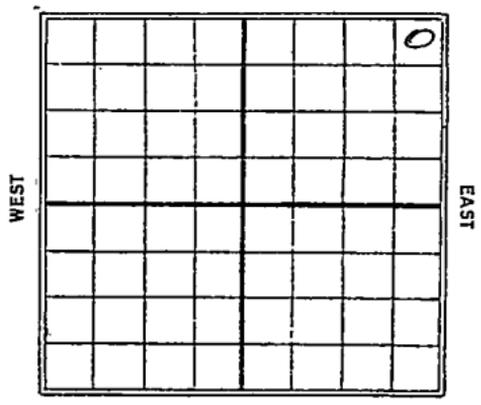

*1930*

Date

REPORT

<i>4/2</i>	<i>Sdy.</i>
<i>4/9</i>	<i>1 Hdg. 340'</i>
<i>4/16</i>	<i>12" - 822 Hdg 965'</i>
<i>4/23</i>	<i>1 Hdg. 1875'</i>
<i>4/30</i>	<i>" 2030'</i>
<i>5/7</i>	<i>" 2453'</i>
<i>5/14</i>	<i>Top Shat 2558'</i> <i>Base line 2670</i>
	<i>S.D.</i>
<i>5/21</i>	<i>Chat 2560-2670</i> <i>small show</i> <i>Top Viola 2750</i> <i>7FW 2785' TD</i> <i>Dry &amp; Abandon</i>

*Butler*

**KANSAS**  
 Map No. *14* Sec. *28* Twp. *25* R. *4*<sup>E</sup>  
 Well No. *4* *Pierce*  
*Alison Fitzwilliams* Company

Contractor

**FIRST REPORTS**

*330* Ft. from N. Line  
 \_\_\_\_\_ Ft. from S. Line  
*330* Ft. from E. Line  
 \_\_\_\_\_ Ft. from W. Line

**SECTION PLAT**

			o

Location \_\_\_\_\_  
 Rig up \_\_\_\_\_  
 Drilling and Remarks:

*Spdy*

**RECORD**

Cased \_\_\_\_\_ in., \_\_\_\_\_ ft.  
 Sand \_\_\_\_\_  
 Gas \_\_\_\_\_  
 Oil \_\_\_\_\_  
 Total Depth \_\_\_\_\_

**PRODUCTION**

1st 24 hrs. Nat. \_\_\_\_\_  
 1st 24 hrs. after shot \_\_\_\_\_  
 Gas \_\_\_\_\_ Cu. Ft.  
 Dry Hole \_\_\_\_\_  
 Abandoned \_\_\_\_\_

Date

APR 2 1930

**CHAS. L. SHERWOOD**

192 \_\_\_\_\_ Scout

Butler

14

Map No. ~~KANSAS~~ Sec. 78 Twp. 75 R. 4

Well No. 4 Pierre

Alison - Fitzwilliams Company

Contractor

COMPLETE

SECTION PLAT

330 Ft. from N. Line

\_\_\_\_\_ Ft. from S. Line

330 Ft. from E. Line

\_\_\_\_\_ Ft. from W. Line

			0

ABANDONED

Location \_\_\_\_\_

Rig up \_\_\_\_\_

Drilling and Remarks:

Tap Viola - 2750'

HFW 2785'

RECORD

Cased \_\_\_\_\_ in., \_\_\_\_\_ ft.

Sand Chat 2560-2670

Gas Small Shows

Oil \_\_\_\_\_

Total Depth 2785

PRODUCTION

1st 24 hrs. Nat. \_\_\_\_\_

1st 24 hrs. after shot \_\_\_\_\_

Gas \_\_\_\_\_ Cu. Ft.

Dry Hole

Abandoned

Date

MAY 21 1920

CHAS. L. SHERWOOD

19

Scout