



Map No. KANSAS Sec. 28 Twp. 25 R. 4<sup>E</sup>

Well No. 5 - Pierce Farm

Allison-Fitzwilliams Company

NORTH


990 Ft. from N. Line

~~990~~ Ft. from S. Line

\_\_\_\_\_ Ft. from E. Line

330 Ft. from W. Line

1930

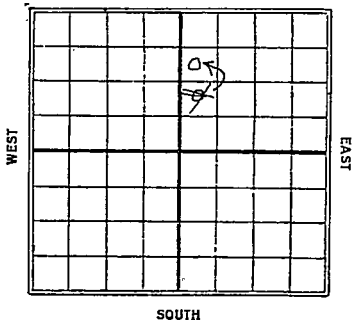

Date

REPORT

Date	REPORT
9/24	Peg
10/11	Peg
10/18	Ryn up
10/15	Peg
10/22	Depth 200'
10/28	Depth 800'
11/5	" " 1510'
11/12	10" - 1602
	HFW 1665-75
	T.D. 1760' U/R 10"
11/19	Drly 2220'
11/26	" " 2575
12/13	Top line 2571-2675
	Show 2571-2612
	Top Viola 2724
	Wily 2725
12/10	Top line 2571-2675
	Show 2571-2612
	Top Viola 2750
	T.D. 2757 HFW
	Dry & abandon

*Butler*

Map No. KANSAS Sec. 28 Twp. 75 R. 4<sup>E</sup>

Well No. 5 *Pierce*

*allison & Fitzwilliams* Company Contractor

**FIRST REPORTS**

\_\_\_\_\_ Ft. from N. Line

990 Ft. from S. Line

\_\_\_\_\_ Ft. from E. Line

330 Ft. from W. Line

**SECTION PLAT**

		o	

Location \_\_\_\_\_

Rig up

Drilling and Remarks:

**RECORD**

Cased \_\_\_\_\_ in., \_\_\_\_\_ ft.

Sand \_\_\_\_\_

Gas \_\_\_\_\_

Oil \_\_\_\_\_

Total Depth \_\_\_\_\_

**PRODUCTION**

1st 24 hrs. Nat. \_\_\_\_\_

1st 24 hrs. after shot \_\_\_\_\_

Gas \_\_\_\_\_ Cu. Ft.

Dry Hole \_\_\_\_\_

Abandoned \_\_\_\_\_

Date  
**SEP 24 1930**

**CHAS. L. SHERWOOD**  
Scout

*Butler*

Map No. KANSAS Sec. 28 Twp. 25 R. 4 <sup>E</sup>

Well No. 5 *Pierce*

*Allison & Fitzwilliams* Company

Contractor

**CORRECTION**

990 Ft. from N. Line

..... Ft. from S. Line

..... Ft. from E. Line

330 Ft. from W. Line

**SECTION PLAT**

		05	
		05	

Location.....

Rig up.....

Drilling and Remarks:

*Chg Location*

**RECORD**

Cased.....in., .....ft.

Sand.....

Gas.....

Oil.....

Total Depth.....

**PRODUCTION**

1st 24 hrs. Nat.....

1st 24 hrs. after shot.....

Gas.....Cu. Ft.

Dry Hole.....

Abandoned.....

Date

NOV. 19 1930

192

**CHAS. L. SHERWOOD**  
Scout

Butler

Map No. KANSAS Sec. 28 Twp. 25 R. H

Well No. 5

allison Piers Fitzwilliams Company

Contractor

COMPLETE

SECTION PLAT

990 Ft. from N. Line

..... Ft. from S. Line

..... Ft. from E. Line

230 Ft. from W. Line

		0	

ABANDONED

Location.....

Rig up.....

Drilling and Remarks:

Top line 2571-2675  
 Show 2571-2612  
 Top Viola 2750  
 Sta 2757

RECORD

Cased.....in., .....ft.

Sand.....

Gas.....

Oil.....

Total Depth 2757

PRODUCTION

1st 24 hrs. Nat.....

1st 24 hrs. after shot.....

Gas..... Cu. Ft.

Dry Hole

Abandoned

Date

DEC 10 1930

CHAS. L. SHERWOOD